

STATE ENGINEER
Salem, Oregon

WASH
6447

Well Record

STATE WELL NO. 1N/3W-33Q
COUNTY Washington
APPLICATION NO. GR-3058

OWNER: Larry C. Jensen


MAILING ADDRESS: 434 N. W. 7th Avenue

LOCATION OF WELL: Owner's No.

CITY AND STATE: Cornelius, Oregon

SW ¼ SE ¼ Sec. 33 T. 1 N. R. 3 W., W.M.

Bearing and distance from section or subdivision corner 1000' N. and 200' E.

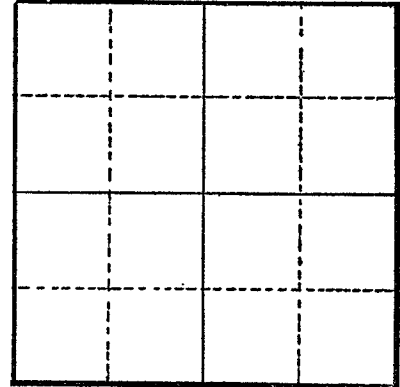

Section

Altitude at well

TYPE OF WELL: drilled Date Constructed 1954

Depth drilled 30' Depth cased 30'

CASING RECORD:

4"

FINISH:

AQUIFERS:

top soil and sand

WATER LEVEL:

12'

PUMPING EQUIPMENT: Type Fairbanks Morse deep well Jet 1" H.P. 1
Capacity 20 G.P.M.

WELL TESTS:

Drawdown 8 ft. after hours pumping 68 G.P.M.

Drawdown 13 ft. after hours pumping 120 G.P.M.

USE OF WATER Irrigation Temp. °F., 19

SOURCE OF INFORMATION GR-2863

DRILLER or DIGGER

ADDITIONAL DATA:

Log Water Level Measurements Chemical Analysis Aquifer Test

REMARKS:

Top soil	2	2
Sand water bearing at 6'	30	28