

STATE ENGINEER  
Salem, Oregon

WASH  
6499  
**Well Record**

STATE WELL NO. 1N/3W - 35Q  
COUNTY WASHINGTON  
APPLICATION NO. GR-2010

OWNER: Carl Russell & Winona L. Russell MAILING ADDRESS: Rt. 2, Box 414

LOCATION OF WELL: Owner's No. \_\_\_\_\_ CITY AND STATE: Hillsboro, Oregon

SW  $\frac{1}{4}$  SE  $\frac{1}{4}$  Sec. 35 T. 1 N. 3 E. W., W.M.

Bearing and distance from section or subdivision corner 410' N. & 310' E.

Altitude at well \_\_\_\_\_

TYPE OF WELL: Drilled Date Constructed 1954

Depth drilled 68' Depth cased 58'

CASING RECORD:

6-inch

FINISH:

AQUIFERS:

WATER LEVEL:  
18-feet

PUMPING EQUIPMENT: Type Delco Model A8441 H.P. 1  
Capacity 35 G.P.M.

WELL TESTS:  
Drawdown 16 ft. after \_\_\_\_\_ hours Pumping 35 G.P.M.  
Drawdown \_\_\_\_\_ ft. after \_\_\_\_\_ hours \_\_\_\_\_ G.P.M.

USE OF WATER Irrigation Temp. \_\_\_\_\_ °F., 19 \_\_\_\_\_


SOURCE OF INFORMATION GR-1938

DRILLER or DIGGER J. H. O'Neel, 431 S. 9th St., Hillsboro, Oregon

ADDITIONAL DATA:

Log \_\_\_\_\_ Water Level Measurements \_\_\_\_\_ Chemical Analysis \_\_\_\_\_ Aquifer Test \_\_\_\_\_

REMARKS:

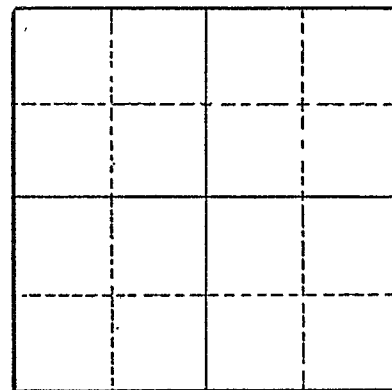

Section \_\_\_\_\_