

STATE ENGINEER  
Salem, Oregon

WASH  
6502

# Well Record

STATE WELL NO. LN/3W-36  
COUNTY WASHINGTON  
APPLICATION NO. GR-2340

OWNER: C. C. Snyder


MAILING ADDRESS: 1100 NW 317th Ave.

LOCATION OF WELL: Owner's No. \_\_\_\_\_

CITY AND STATE: Hillsboro, Oregon

1/4 1/4 Sec. 36 T. 1 N. S. R. 3 E. W., W.M.

Bearing and distance from section or subdivision corner 2200' E. and 2400' S.

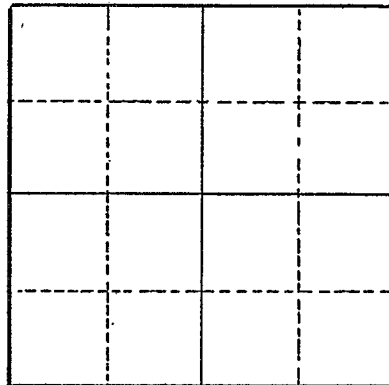

Section \_\_\_\_\_

Altitude at well \_\_\_\_\_

TYPE OF WELL Dug & Drilled Date Constructed 1946

Depth drilled 45 Depth cased 40

### CASING RECORD:

6-inch

### FINISH:

### AQUIFERS:

### WATER LEVEL:

20-feet

PUMPING EQUIPMENT: Type Pacific H.P. 3/4  
Capacity 20 G.P.M.

### WELL TESTS:

Drawdown ? ft. after \_\_\_\_\_ hours Pumping 15 G.P.M.  
Drawdown \_\_\_\_\_ ft. after \_\_\_\_\_ hours \_\_\_\_\_ G.P.M.

USE OF WATER Irrigation Temp. \_\_\_\_\_ °F. \_\_\_\_\_, 19\_\_\_\_\_

SOURCE OF INFORMATION GR-2224

DRILLER or DIGGER Taylor (deceased)

### ADDITIONAL DATA:

Log \_\_\_\_\_ Water Level Measurements \_\_\_\_\_ Chemical Analysis \_\_\_\_\_ Aquifer Test \_\_\_\_\_

### REMARKS: