

STATE ENGINEER
Salem, Oregon

WASH
6515

Well Record

STATE WELL NO. IN/310-36.60
COUNTY Washington
APPLICATION NO. GR-163

OWNER: Charles C. Martin


MAILING ADDRESS: 1435 NW Connell Ave.

LOCATION OF WELL: Owner's No. 1

CITY AND STATE: Hillsboro, Oregon.

SW of NE
SE 1/4 SE 1/4 Sec. 36 T. 1 N. 5, R. 3 W., W.M.

Bearing and distance from section or subdivision corner N 10° 40' W 10,724 feet from SW corner
A. Kelsey D.L.C.

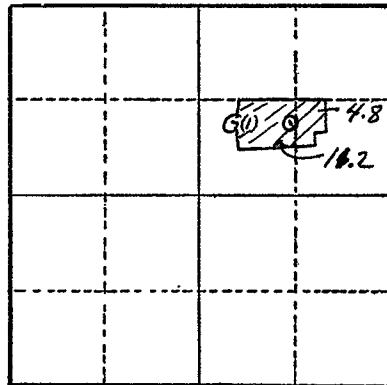

Section 36

Altitude at well 200 feet Interpolated

TYPE OF WELL: Drilled Date Constructed 8/5/48

Depth drilled 50' Depth cased 50'

CASING RECORD:

6 — inch steel casing set from 0 to 50 feet.

FINISH:

None

AQUIFERS:

unknown

WATER LEVEL:

30 feet below land surface.

PUMPING EQUIPMENT: Type Goulds Jet 2" H.P. 2
Capacity 100 G.P.M.

WELL TESTS:

Drawdown 35 ft. after _____ hours pumping 85 G.P.M.
Drawdown _____ ft. after _____ hours _____ G.P.M.

USE OF WATER Irrigation 16 acres Temp. _____ °F. _____, 19____

SOURCE OF INFORMATION Registration Statement GR-163

DRILLER or DIGGER J.H. O'Neal 431 S 9th St. Hillsboro, Oregon

ADDITIONAL DATA:

Log NO Water Level Measurements _____ Chemical Analysis _____ Aquifer Test _____

REMARKS: