

STATE ENGINEER
Salem, Oregon

WASH 6517
Well Record


STATE WELL NO. 1N/3W-36K
COUNTY WASHINGTON
APPLICATION NO. GR-2364

OWNER: W. H. Treglown
MAILING ADDRESS: 31235 W. Jackson St

LOCATION OF WELL: Owner's No. _____
CITY AND STATE: Hillsboro, Oregon

NW 1/4 SE 1/4 Sec. 36 T. 1 N. R. 3 W., W.M.

Bearing and distance from section or subdivision
corner 1900' W & 2030' N of SE cor SEC 36

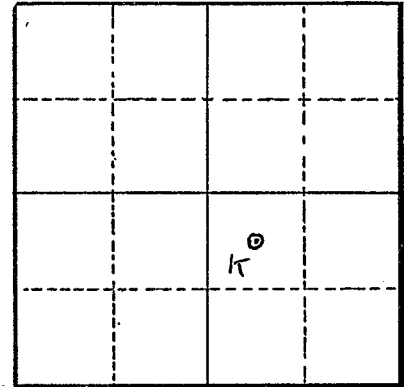

Section 36

Altitude at well _____

TYPE OF WELL: Drilled Date Constructed 1950

Depth drilled 54' Depth cased _____

CASING RECORD:

FINISH:

AQUIFERS:

WATER LEVEL:

PUMPING EQUIPMENT: Type Berkley H.P. 1
Capacity 1000 G.P.M.

WELL TESTS:
Drawdown _____ ft. after _____ hours 1000 G.P.M.
Drawdown _____ ft. after _____ hours _____ G.P.M.

USE OF WATER Irrigation Temp. °F. _____, 19

SOURCE OF INFORMATION GR-3917

DRILLER or DIGGER _____

ADDITIONAL DATA:

Log NA Water Level Measurements _____ Chemical Analysis _____ Aquifer Test _____

REMARKS: