
File Original and First Copy with the STATE ENGINEER, SALEM, OREGON


OCT 26 1961 WATER WELL REPORT WASH STATE E. GINEER STATE OF OREGON 6534

State Permit No.

(1) OWNER:	(11) WELL TESTS: Drawdown is amount water level is lowered below static level		
Name Norbert Krieger	Was a pump test made? Yes \(\subseteq No \) If yes, by who		. Drill
Address Rt. 2 Box 271	Yield: 6 gal./min. with 45 ft. drawdow		
Forest Grove, Oregon	79 29		**
(2) LOCATION OF WELL:	27 29		••
County WASH Owner's number, if any—	Bailer test gal./min. with ft. drawdow	n after	hrs.
1/4 1/4 Section 1 T. 1 N R. L W W.M.	Artesian flow g.p.m. Date		
Bearing and distance from section or subdivision corner	Temperature of water 54 Was a chemical analysis m	ade? 🔲 Yes	No No
	(12) WELL LOG: Diameter of well	6	inches.
	Depth drilled 137 ft. Depth of completed w	_	
	Formation: Describe by color, character, size of materishow thickness of aquifers and the kind and nature of		
	show thickness of aquifers and the kind and nature of stratum penetrated, with at least one entry for each of	the materia change of fo	l in each ormation.
	MATERIAL	FROM	то
(3) TYPE OF WORK (check):	0.41 0	0	
Well ☑ Deepening ☐ Reconditioning ☐ Abandon ☐	Soil Brown	20	20 38
andonment, describe material and procedure in Item 11.	Blue Clay	38	
	Silt and Brown Clay	50	5 0
PROPOSED USE (check): (5) TYPE OF WELL:	Brown Clay	70	70
Domestic ☑ Industrial ☐ Municipal ☐ Rotary ☐ Driven ☐	Sand and Clay	1 * *	_90
Irrigation Test Well Other Dug Bored	Brown Clay	90	-97
	Sand Brown	97	107
(6) CASING INSTALLED: Threaded □ Welded ☑	Brown Clay	107	113-
6	Sand Brown	113	-121
"Diam. fromft. toft. Gage	Brown Clay	121	123
"Diam. fromft. toft. Gage	Sand Brown	123	+37
(7) PERFORATIONS: Perforated? ☐ Yes ☑ No			
Type of perforator used			
SIZE of perforations in. by in.			
perforations from			77
perforations from			
perforations fromft. toft.			
perforations fromft. toft.	,		
perforations from ft. to ft.			
(8) SCREENS: Well screen installed ☐ Yes ☑ No			
Manufacturer's Name			
Type Model No.			
Slot size Set from ft. to ft.			
Design Slot size Set from ft. to ft.	Work started September 4 1961. Completed Oct	robon 7	19 6 1
	3 September 4, ut	over /,	
(9) CONSTRUCTION:	(13) PUMP:		
Was well gravel packed? ☐ Yes ☒ No Size of gravel:	Manufacturer's NameConop	****************	*******
Gravel placed from ft. to ft.	Type:		
Was a surface seal provided? Yes No To what depth? ft.			
Material used in seal—	Well Driller's Statement:		
Did any strata contain unusable water? ☐ Yes ☒ No	This well was drilled under my jurisdiction	and this re	eport is
Type of water? Soft Depth of strata 25 ft.	true to the best of my knowledge and belief.		-
Method of sealing strata offShoe Welded at bottom of casin	NAME Cyril Vandehey	**************	
(10) WATER LEVELS:	(Person, firm, of corporation) (T	ype or print))
Static level 25 ft. below land surface Date 10-7-61	Address Rt. 2 Box 262 Forest Grove, Oregon		
Artesian pressure lbs. per square inch Date			
	Driller's well number6		
Log Accepted by:	[Signed] Cyn Uandhii		
[Signed] Losters of True Date 10-2/ 1961	(Well Driller)		
(Owner)	License No. 4 353 Date 10-2	0/	1961

Beginning at the northeast corner of the D.L.C. of John Kirts, it being the northeast cornor of the southeast quarter of Section 1, T. 1N., R. 4W., and running thence south 40 rods.; thence west 40 rods, thence north 40 rods; thence east 40 rods to the place of beginning. Containing 10 acres, more or less.

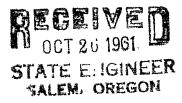

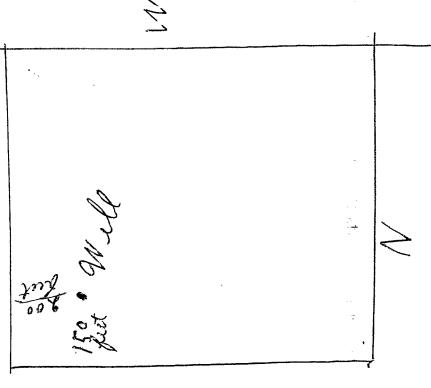

1