

STATE ENGINEER
Salem, Oregon

WASH
6639

Well Record


STATE WELL NO. 1N/4W-10P1
COUNTY Wash.
APPLICATION NO. GR-419

OWNER: Bernard W. Gent MAILING ADDRESS: Pt. 1 Box 314

LOCATION OF WELL: Owner's No. _____ CITY AND STATE: Forest Grove, Ore.

SE 1/4 SW 1/4 Sec. 10 T. 1 N. 3 R. 4 W., W.M.

Bearing and distance from section or subdivision corner N. 45° 40' E. 511.5 Ft.
to N.E. cor. William B. Poe
DLC

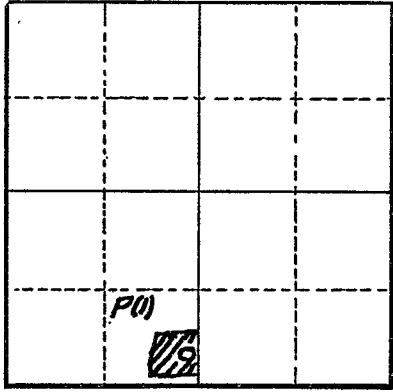

Section 10

Altitude at well 185

TYPE OF WELL: drilled Date Constructed June 7 '45

Depth drilled 343 Depth cased 321

CASING RECORD:
6 inch

FINISH:

AQUIFERS:

WATER LEVEL:

Flowing

PUMPING EQUIPMENT: Type None H.P. _____
Capacity None G.P.M. _____

WELL TESTS:

Drawdown _____ ft. after _____ hours _____ G.P.M.
Drawdown _____ ft. after _____ hours _____ G.P.M.

USE OF WATER irrigation - 4 Temp. _____ °F. _____, 19____

SOURCE OF INFORMATION GR-419

DRILLER or DIGGER A. J. Gaunt; Aloha, Ore

ADDITIONAL DATA:

Log _____ Water Level Measurements _____ Chemical Analysis _____ Aquifer Test _____

REMARKS:

Clay - - - - - 0 to 323 ft.
Shale & sandstone 323 to 343 ft.