

STATE ENGINEER
Salem, Oregon

WASH 0643 Well Record

STATE WELL NO. 1N/4W-11C(1)
COUNTY Washington
APPLICATION NO. GR-769

OWNER: Vernon E. & Lavine B. Lyda


MAILING ADDRESS: Rt 1, Box 351 P.O. 2

LOCATION OF WELL: Owner's No. 1

CITY AND STATE: Forest Grove, Oregon

NE 1/4 NW 1/4 Sec. 11 T. 1 N. R. 4 W., W.M.

Bearing and distance from section or subdivision corner N 80° 43' W 1841.71 feet To NW corner section 11 T. 1 N., R. 4 W.

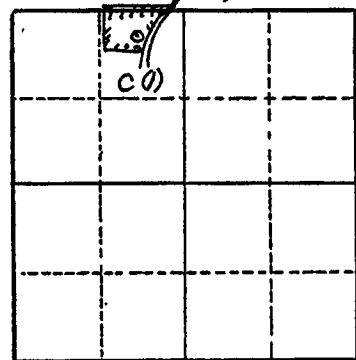

Section 11

Altitude at well 180 feet Interpolated

TYPE OF WELL: Drilled Date Constructed 20 Aug 1952

Depth drilled 410 ft. Depth cased 403 ft.

CASING RECORD:

6 inch	OD casing	0 to 356' 7"
4 inch	Pipe 17"x4"x4" std.	356' 7" to 374' 1"
6 inch	Rock	356' to 403'

FINISH:

AQUIFERS:

WATER LEVEL:

100 feet

PUMPING EQUIPMENT: Type Elect. - Universal jet 1 1/2" H.P. 1 1/2
Capacity 25 G.P.M.

WELL TESTS:

Drawdown	55	ft. after	hours	30	G.P.M.
Drawdown	0	ft. after	hours	6-8	G.P.M.

USE OF WATER Irrigation Temp. °F. 19

SOURCE OF INFORMATION GR- 769

DRILLER or DIGGER

ADDITIONAL DATA:

Log Yes Water Level Measurements Chemical Analysis Aquifer Test

REMARKS:

