

STATE ENGINEER  
Salem, Oregon

WASH  
6644

# Well Record

STATE WELL NO. 1N/4W-11D  
COUNTY Washington  
APPLICATION NO. GR-3064

OWNER: J. A. Feazle


MAILING ADDRESS: Route 1

LOCATION OF WELL: Owner's No. \_\_\_\_\_

CITY AND STATE: Madras, Oregon

NW  $\frac{1}{4}$  NW  $\frac{1}{4}$  Sec. 11 T. 1 N. S., R. 4 E. W., W.M.

Bearing and distance from section or subdivision corner 1325 chs. E. and 200 ft. S.

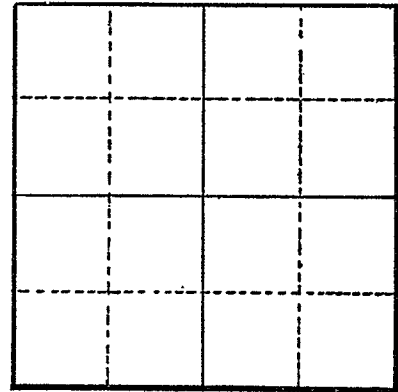

Section \_\_\_\_\_

Altitude at well \_\_\_\_\_

TYPE OF WELL: Drilled Date Constructed 1950

Depth drilled 428 feet Depth cased 390' 6"

### CASING RECORD:

6-inch from 0' to 54' 7"  
6- & 5 5/8-inch from 54' 7" to 390' 6"

### FINISH:

### AQUIFERS:

Red shot clay, lava rock, and hard rock

### WATER LEVEL:

Artesian

PUMPING EQUIPMENT: Type Fairbanks-Morse Jet H.P. 5

Capacity 66 G.P.M.

### WELL TESTS:

Drawdown 0 ft. after \_\_\_\_\_ hours Pumping 7 G.P.M.

Drawdown 50 ft. after \_\_\_\_\_ hours Pumping 66 G.P.M.

USE OF WATER Irrigation Temp. \_\_\_\_\_ °F., 19

SOURCE OF INFORMATION GR-2867

DRILLER or DIGGER A. M. Janssen Drilling Co.

### ADDITIONAL DATA:

Log  Water Level Measurements \_\_\_\_\_ Chemical Analysis \_\_\_\_\_ Aquifer Test \_\_\_\_\_

### REMARKS:

Red shot clay	309	336	27
Lava rock	336	413	77
Hard rock	413	428	15