


WASH 68072

N

Decomission Map

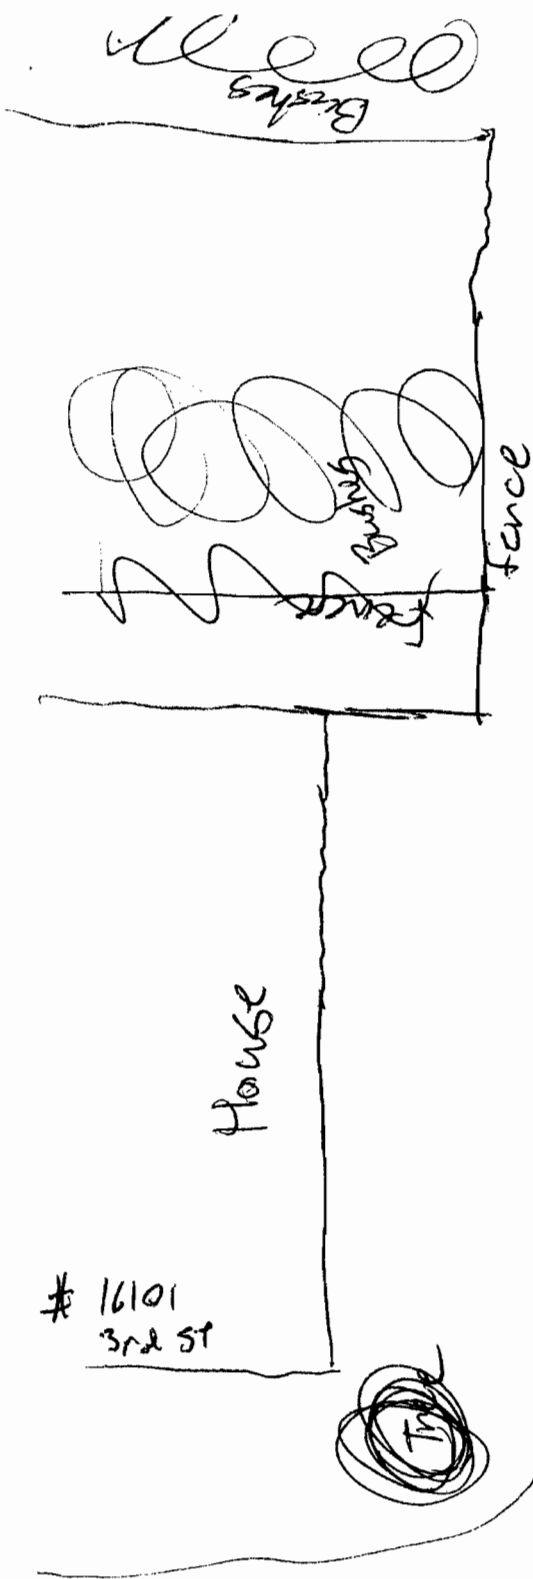

16101
3rd St

~~D-1~~

~~D-2~~

~~D-3~~

~~D-4~~

D-5

D-6

D-7

D-8

D-9

12' Centers

Washington St

3rd St

RECEIVED

JUL 13 2009

WATER RESOURCES DEPT
SALEM, OREGON



WASH 68072

Oregon

Theodore R. Kulongoski, Governor

Water Resources Department

North Mall Office Building
725 Summer Street NE, Suite A
Salem, OR 97301-1266
503-986-0900
FAX 503-986-0904

June 26, 2009

WILLIAM 'BRAD' WRIGHT #1772
WESTERN STATES SOIL CONS. INC
PO BOX 428
HUBBARD OR 97032

FINAL ORDER

Dear Mr. Wright:

The Special Standard request you submitted for owner: City of Sherwood, Start Card numbers 1007254 thru 1007262, is hereby approved for the following: You may abandon these dewatering wells by pulling out the casing and backfilling the remaining boreholes with unhydrated bentonite to land surface. All other standards must be adhered to. A copy of your Special Standard Request Form is enclosed.

The Well Construction Standards serve to protect ground water resources. By approving and issuing this special construction standard the Oregon Water Resources Department is not representing that a well constructed in accordance with this condition will maintain structural integrity or that it meets engineering standards. The well constructor/or landowner is responsible for ensuring that a well is constructed in a manner that protects ground water resources as required under Oregon Administrative Rules 690-200 through 690-240.

If you have any questions regarding this letter, I may be contacted at (503) 986-0851, or by e-mail at Kristopher.R.Byrd@wrdd.state.or.us.

Sincerely,



Kristopher Byrd, Coordinator
Well Construction Program
Well Construction and Compliance Section

enclosure

cc: Joel Jeffery, NW Region Well Inspector
File

RECEIVED

JUL 13 2009

**WATER RESOURCES DEPT
SALEM, OREGON**

This is a final order in other than a contested case. This order is subject to judicial review under ORS 183.484. Any petition for judicial review must be filed within the 60 day time period specified by ORS 183.484(2). Pursuant to ORS 536.075 and OAR 137-004-0080 you may either petition for judicial review or petition the Director for reconsideration of this order. A petition for reconsideration may be granted or denied by the director, and if no action is taken within 60 days following the date the petition was filed, the petition shall be deemed denied.