

(5) BORE HOLE CONSTRUCTION

[illegible]

FILTER PACK

From	To	Material	Size

(6) CASING/LINER

Casing Liner	Dia.	+	From	To	Gauge	Stl	Pstlc	Wld	Thrd

(7) PERFORATIONS/SCREENS

[illegible]

(8) WELL TESTS: Minimum testing time is 1 hour

Yield gal/min	Drawdown	Drill stem/Pump depth	Duration (hr)

Water Quality Concerns

From	To	Description	Amount	Units

(10) STATIC WATER LEVEL

Water Bearing Zones

[illegible]

(11) WELL LOG

[illegible]

RECEIVED
MAY 13 2010
WATER RESOURCES DEPT
SALEM, OREGON

Comments/Remarks

Dewatering well was abandoned by bentonite grout from 20' to 0'


Casing and riser removed.

Original Startcard: 1009447

Well ID Tag: 103410

Map of well

WASH 68755

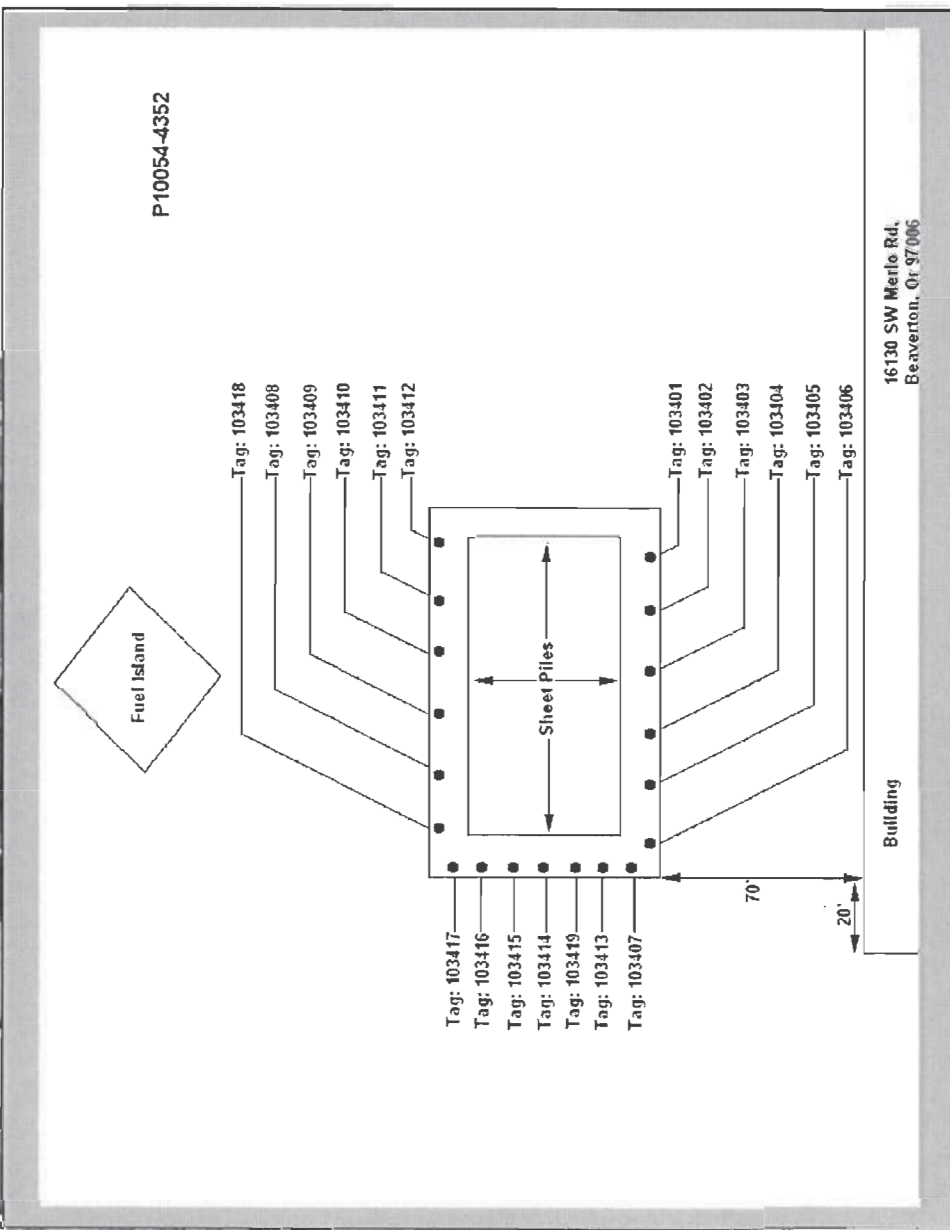

RECEIVED
MAY 13 2010
WATER RESOURCES DEPT
SALEM, OREGON