

STATE OF OREGON

WATER SUPPLY WELL REPORT

(as required by ORS 537.765 & OAR 690-205-0210)

05-14-2010

WELL LABEL # L 100448

START CARD # 1010051

(1) LAND OWNER

Owner Well I.D. 2/10-4

First Name _____ Last Name _____
 Company CLEAN WATER SERVICES
 Address 16060 SW 85TH
 City TIGARD State OR Zip 97224

(2) TYPE OF WORK ☐ New Well ☐ Deepening ☐ Conversion
☐ Alteration (repair/recondition) ☒ Abandonment

(3) DRILL METHOD

☐ Rotary Air ☐ Rotary Mud ☐ Cable ☐ Auger ☐ Cable Mud
☐ Reverse Rotary ☒ Other Pull Casing and seal

(4) PROPOSED USE ☐ Domestic ☐ Irrigation ☐ Community☐ Industrial/ Commercial ☐ Livestock ☒ Dewatering☐ Thermal ☐ Injection ☐ Other _____(5) BORE HOLE CONSTRUCTION Special Standard ☐ Attach copy)Depth of Completed Well 39.00 ft.

BORE HOLE			SEAL			sacks/	
Dia	From	To	Material	From	To	Amt	lbs
6	0	40	Bentonite Chips	0	5	2	S
			Cement	5	40	2	S

How was seal placed: Method ☐ A ☐ B ☐ C ☐ D ☐ E☐ Other _____

Backfill placed from _____ ft. to _____ ft. Material _____

Filter pack from _____ ft. to _____ ft. Material _____ Size _____

Explosives used: ☐ Yes Type _____ Amount _____

(6) CASING/LINER

Casing	Liner	Dia	+	From	To	Gauge	Stl	Plstc	Wld	Thrd
☒	☐	6	☐	0	39	280	☒	☐	☒	☐

Shoe ☐ Inside ☐ Outside ☐ Other Location of shoe(s) _____Temp casing ☐ Yes Dia _____ From _____ To _____

(7) PERFORATIONS/SCREENS

Perforations Method _____

Screens Type _____ Material _____

Perf/S	Casing/	Screen	Dia	From	To	Screen/slot	Slot	# of	Tele/
creen	Liner					width	length	slots	pipe size

(8) WELL TESTS: Minimum testing time is 1 hour

☐ Pump ☐ Bailer ☐ Air ☐ Flowing Artesian

Yield gal/min Drawdown Drill stem/Pump depth Duration (hr)

--	--	--	--

Temperature _____ °F Lab analysis ☐ Yes By _____Water quality concerns? ☐ Yes (describe below)

From	To	Description	Amount	Units
------	----	-------------	--------	-------

(9) LOCATION OF WELL (legal description)

County Washington Twp 1.00 S N/S Range 3.00 W E/W WMSec 5 NW 1/4 of the SW 1/4 Tax Lot 100

Tax Map Number _____ Lot _____

Lat _____ " or _____ DMS or DD

Long _____ " or _____ DMS or DD

☐ Street address of well ☐ Nearest address

1354 SW FERN HILL RD FOREST GROVE, OR 97116

(10) STATIC WATER LEVEL

Date _____ SWL(psi) + SWL(ft)

Existing Well / Predeepening _____

Completed Well _____

Flowing Artesian? ☐ Dry Hole? ☐

WATER BEARING ZONES

Depth water was first found _____

SWL Date From To Est Flow SWL(psi) + SWL(ft)

(11) WELL LOG

Ground Elevation _____

Material From To

Abandoned dewatering well by filling hole while casing

removed 0 40

RECEIVED

RECEIVED

JUL 01 2010

MAY 24 2010

WATER RESOURCES DEPT WATER RESOURCES DEPT

SALEM, OREGON

SALEM, OREGON

Date Started 05-13-2010 Completed 05-13-2010

(unbonded) Water Well Constructor Certification

I certify that the work I performed on the construction, deepening, alteration, or abandonment of this well is in compliance with Oregon water supply well construction standards. Materials used and information reported above are true to the best of my knowledge and belief.

License Number 1864 Date 05-14-2010

Electronically Filed

Signed RICHARD E O WIGGINS (E-filed)

(bonded) Water Well Constructor Certification

I accept responsibility for the construction, deepening, alteration, or abandonment work performed on this well during the construction dates reported above. All work performed during this time is in compliance with Oregon water supply well construction standards. This report is true to the best of my knowledge and belief.

License Number 1772 Date 05-14-2010

Electronically Filed

Signed WILLIAM 'BRAD' WRIGHT (E-filed)

Contact Info (optional)

ORIGINAL - WATER RESOURCES DEPARTMENT

THIS REPORT MUST BE SUBMITTED TO THE WATER RESOURCES DEPARTMENT WITHIN 30 DAYS OF COMPLETION OF WORK

Form Version: 0.95

WASH 68843

WASH 68843

WELL I.D. # L 100448

Page 2 of 2

WATER SUPPLY WELL REPORT -
continuation page

05-14-2010


START CARD # 1010051

Map of well

GEOTECHNICAL HOLE REPORT -

Map with location identified must be attached and shall
include an approximate scale and north arrow

Map of Hole

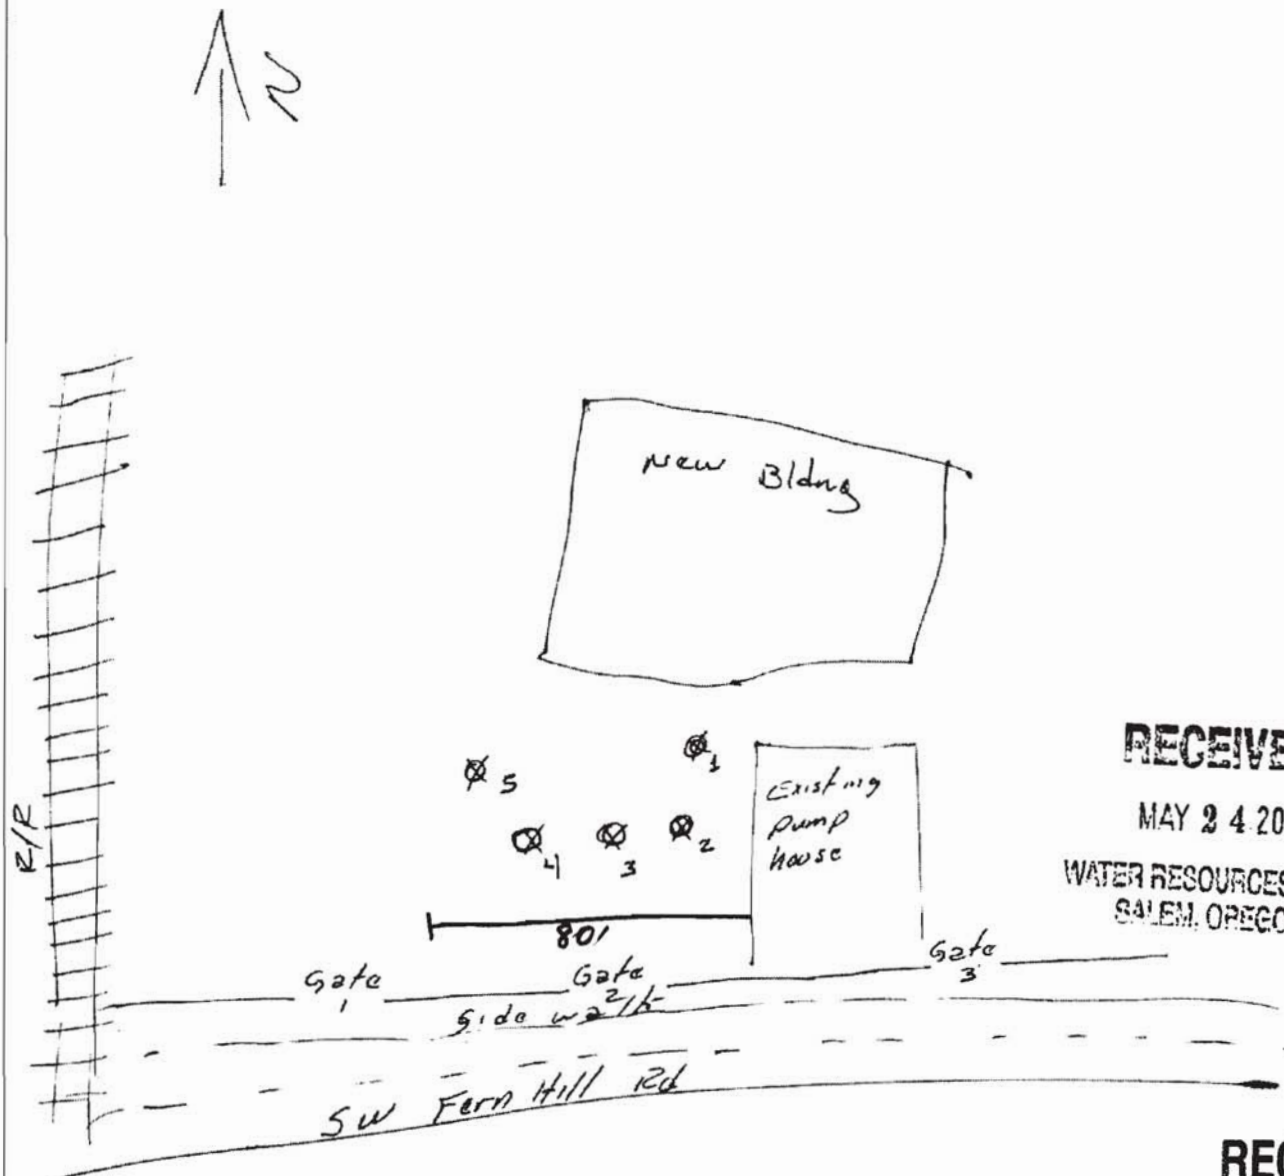

RECEIVED

MAY 24 2010

WATER RESOURCES DEPT
SALEM, OREGON

RECEIVED

JUL 01 2010

WATER RESOURCES DEPT
SALEM, OREGON