

WASH 68844

WATER SUPPLY WELL REPORT -
continuation page

WASH 68844

05-14-2010

WELL I.D. # L 100449

START CARD # 1010052


Page 2 of 2

Map of well

GEOTECHNICAL HOLE REPORT -

Map with location identified must be attached and shall
include an approximate scale and north arrow

Map of Hole

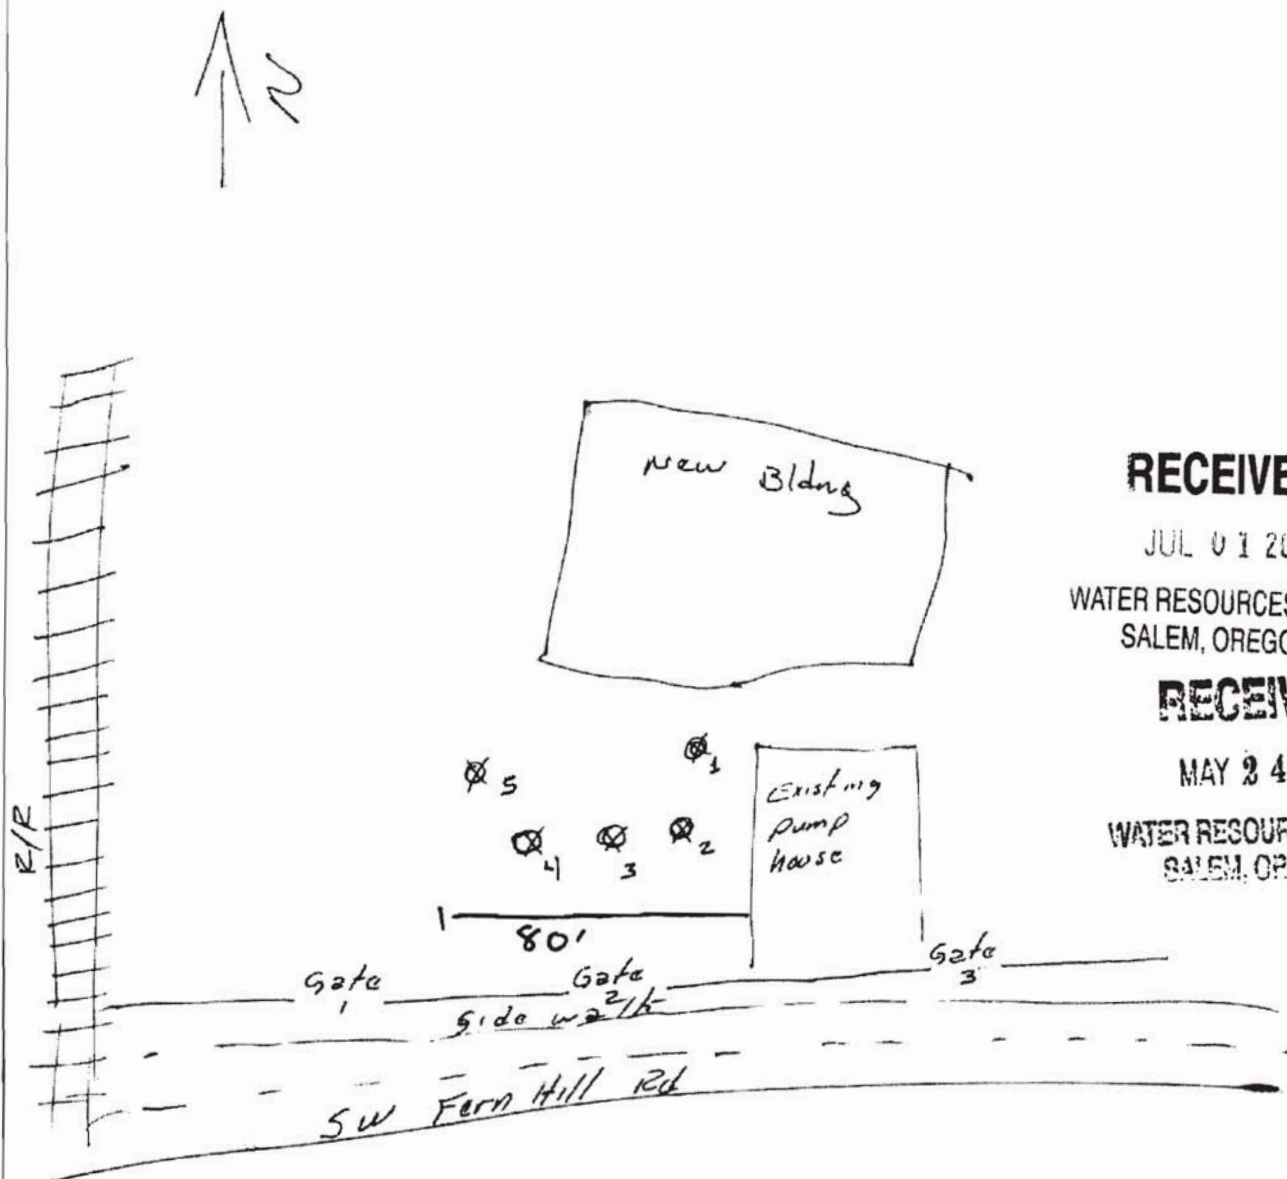

RECEIVED

JUL 01 2010

WATER RESOURCES DEPT
SALEM, OREGON

RECEIVED

MAY 24 2010

WATER RESOURCES DEPT
SALEM, OREGON