

WASH 68845

WASH 68845

WELL I.D. # L 100450

Page 2 of 2

WATER SUPPLY WELL REPORT -
continuation page

05-14-2010


START CARD # 1010053

Map of well

GEOTECHNICAL HOLE REPORT -

Map with location identified must be attached and shall
include an approximate scale and north arrow

Map of Hole

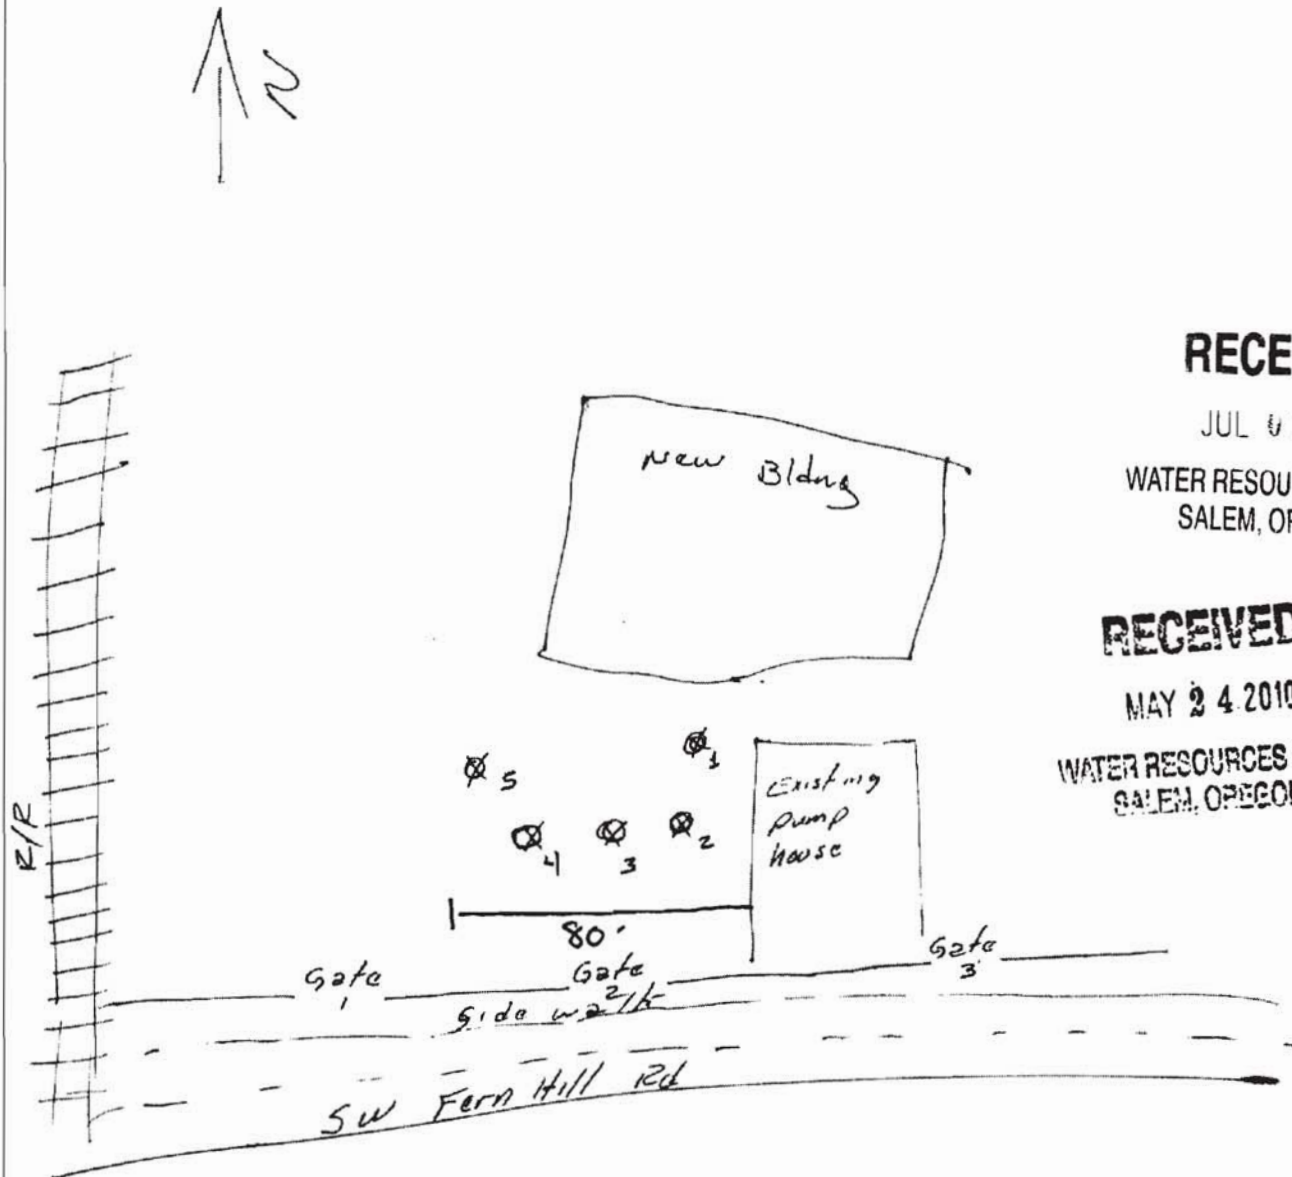

RECEIVED

JUL 01 2010

WATER RESOURCES DEPT
SALEM, OREGON

RECEIVED

MAY 24 2010

WATER RESOURCES DEPT
SALEM, OREGON