

STATE ENGINEER
Salem, Oregon

WASH
6894


Well Record

STATE WELL NO. IN/LW-36G
COUNTY Washington
APPLICATION NO. GR-3341

OWNER: Vera M. Germiquet MAILING ADDRESS: 1713 Camino Drive,
CITY AND STATE: Forest Grove, Oregon

LOCATION OF WELL: Owner's No. _____
SW 1/4 NE 1/4 Sec. 36 T. 1 N. S, R. 4 W., W.M.

Bearing and distance from section or subdivision corner N. 35°15' E. 264.0'

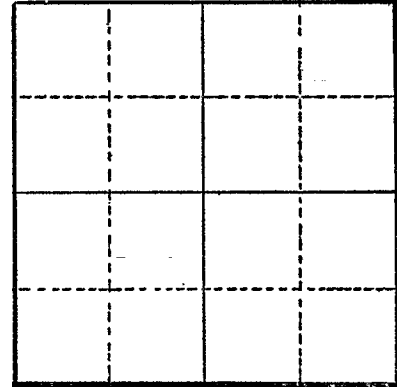

Section _____

Altitude at well _____

TYPE OF WELL: drilled Date Constructed 1952
Depth drilled 110' Depth cased 110'

CASING RECORD:
5 5/8"

FINISH:

Done by Frank Blair
from 20 to 30' from 35 to 40' from 45 to 50'

AQUIFERS:

WATER LEVEL:

8'

PUMPING EQUIPMENT: Type 1 1/2" Jet Pump Johnston Little Beaver H.P. 5
Capacity 50 G.P.M.

WELL TESTS:

Drawdown 80 ft. after _____ hours pumping 18 G.P.M.
Drawdown _____ ft. after _____ hours _____ G.P.M.

USE OF WATER Irrigation Temp. _____ °F. _____, 19____

SOURCE OF INFORMATION GR-3094

DRILLER or DIGGER Frank Blair

ADDITIONAL DATA:

Log _____ Water Level Measurements _____ Chemical Analysis _____ Aquifer Test _____

REMARKS: