

STATE ENGINEER  
Salem, Oregon

WASH  
4182

# Well Record

STATE WELL NO. 2N/2W - 33G  
COUNTY WASHINGTON  
APPLICATION NO. GR-1983

OWNER: Henry Granat


MAILING ADDRESS: Rt. 3, Box 89

LOCATION OF WELL: Owner's No. \_\_\_\_\_

CITY AND STATE: Hillsboro, Oregon

SW 1/4 NE 1/4 Sec. 33 T. 2 N. S., R. 2 W. W.M.

Bearing and distance from section or subdivision corner 3100' S 37° 0' W

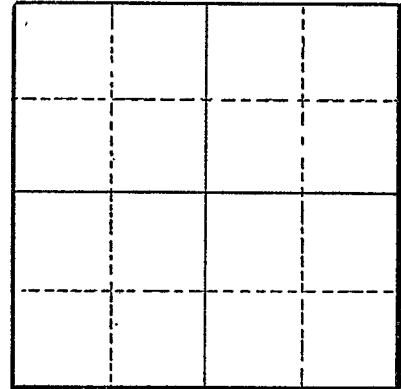

Section \_\_\_\_\_

Altitude at well \_\_\_\_\_

TYPE OF WELL: Drilled Date Constructed 1932

Depth drilled 325 Depth cased 235  
325

### CASING RECORD:

8-inch

### FINISH:

### AQUIFERS:

### WATER LEVEL:

235-feet

PUMPING EQUIPMENT: Type Myers pump H.P. 2  
Capacity 6 G.P.M.

### WELL TESTS:

Drawdown 235 ft. after \_\_\_\_\_ hours Pumping 6 G.P.M.  
Drawdown \_\_\_\_\_ ft. after \_\_\_\_\_ hours \_\_\_\_\_ G.P.M.

USE OF WATER Irrigation Temp. \_\_\_\_\_ °F., 19 \_\_\_\_\_

SOURCE OF INFORMATION GR-1914

DRILLER or DIGGER Well driller deceased

### ADDITIONAL DATA:

Log \_\_\_\_\_ Water Level Measurements \_\_\_\_\_ Chemical Analysis \_\_\_\_\_ Aquifer Test \_\_\_\_\_

### REMARKS: