

STATE ENGINEER
Salem, Oregon

WASH
289

Well Record

STATE WELL NO. 2N/3W - 9G
COUNTY WASHINGTON
APPLICATION NO. GR-2183

OWNER: James W. & Sylvia Williams


MAILING ADDRESS: Rt. 1, Box 150

LOCATION OF WELL: Owner's No.

CITY AND STATE: Cornelius, Oregon

SW 1/4 NE 1/4 Sec. 9 T. 2 N. 8, R. 3 W., W.M.

Bearing and distance from section or subdivision corner 3200' S., 53° 30' W.

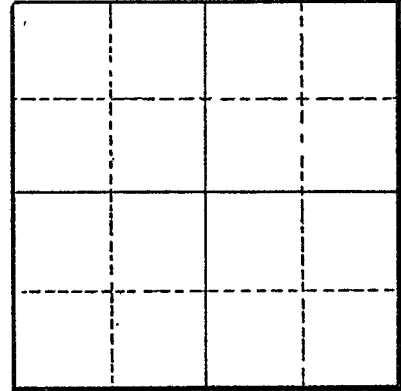

Section

Altitude at well

TYPE OF WELL: Drilled Date Constructed 1953

Depth drilled 75 Depth cased 39

CASING RECORD:

6-Inch

FINISH:

AQUIFERS:

Clay and rock

WATER LEVEL:

24-Feet

PUMPING EQUIPMENT: Type Goulds Jet H.P. 1/4
Capacity 15 G.P.M.

WELL TESTS: Drawdown 26 ft. after hours Pumping 75 G.P.M.
Drawdown ft. after hours G.P.M.

USE OF WATER Irrigation Temp. °F., 19

SOURCE OF INFORMATION GR-2089

DRILLER or DIGGER A. J. Gaunt, 3250 S. W. 185, Albha, Oregon

ADDITIONAL DATA:

Log Water Level Measurements Chemical Analysis Aquifer Test

REMARKS:

Clay 17 17
Blue sand rock 58 75