

STATE ENGINEER
Salem, Oregon

WASH
#541

Well Record

GR- 1611

B 1 of 2
STATE WELL NO. 2N/3W-25N
COUNTY Washington
APPLICATION NO. GR- 1660

OWNER: Fred & Lena Miller

MAILING ADDRESS: Rt. 1, Box 317


LOCATION OF WELL: Owner's No.

CITY AND STATE: Cornelius, Oregon

SW 1/4 SW 1/4 Sec. 25 T. 2 N. R. 3 E. W. W.M.

Bearing and distance from section or subdivision

corner 1100' E. & 750' N. from SW cor. Sec. 25

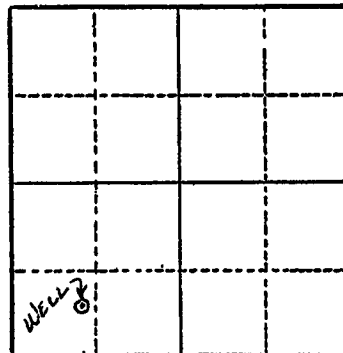

Section 25

Altitude at well 176'

TYPE OF WELL: Drilled Date Constructed 1944

Depth drilled 80' Depth cased 80'

CASING RECORD:

6"

FINISH:

4" perforated 12"

AQUIFERS:

Rock

WATER LEVEL:

20'

PUMPING EQUIPMENT: Type Little Chief Pomona Turbine H.P. 5
Capacity 430 G.P.M.

WELL TESTS:

Drawdown 20 ft. after 333 hours G.P.M.

Drawdown ft. after hours G.P.M.

USE OF WATER Irrigation Temp. °F. 19

SOURCE OF INFORMATION GR Record

DRILLER or DIGGER A. J. Gaunt

ADDITIONAL DATA:

Log N.A. Water Level Measurements Chemical Analysis Aquifer Test

REMARKS:

Irrigation of 8 acres.

