

STATE OF OREGON
WATER SUPPLY WELL REPORT
(as required by ORS 537.765 & OAR 690-205-0210)

WASH 75641

WELL I.D. LABEL# L 100761
START CARD # 1033828
ORIGINAL LOG #

6/9/2017

(1) LAND OWNER Owner Well I.D. ASR TEST WELL
First Name Last Name
Company CITY OF CORNELIUS
Address 1355 N. BARLOW STREET
City CORNELIUS State OR Zip 97113

(2) TYPE OF WORK [ ] New Well [ ] Deepening [ ] Conversion
[X] Alteration (complete 2a & 10) [ ] Abandonment(complete 5a)

(2a) PRE-ALTERATION
Casing: Dia + From To Gauge Stl Plstc Wld Thrd
Seal: Material From To Amt sacks/lbs

(3) DRILL METHOD
[ ] Rotary Air [ ] Rotary Mud [ ] Cable [ ] Auger [ ] Cable Mud
[ ] Reverse Rotary [ ] Other

(4) PROPOSED USE [ ] Domestic [ ] Irrigation [ ] Community
[ ] Industrial/ Commercial [ ] Livestock [ ] Dewatering
[ ] Thermal [ ] Injection [X] Other ASR

(5) BORE HOLE CONSTRUCTION Special Standard [ ] (Attach copy)
Depth of Completed Well ft.

Table with columns: Dia, From, To, Material, SEAL, Amt, sacks/lbs. Includes rows for calculated seal amounts.

How was seal placed: Method [ ] A [ ] B [ ] C [ ] D [ ] E
[ ] Other
Backfill placed from ft. to ft. Material
Filter pack from ft. to ft. Material Size
Explosives used: [ ] Yes Type Amount

(5a) ABANDONMENT USING UNHYDRATED BENTONITE
Proposed Amount P Actual Amount P

(6) CASING/LINER
Casing Liner Dia + From To Gauge Stl Plstc Wld Thrd
Shoe [ ] Inside [ ] Outside [ ] Other Location of shoe(s)
Temp casing [ ] Yes Dia From + To

(7) PERFORATIONS/SCREENS
Perforations Method
Screens Type Material
Perf/ Casing/ Screen Scrn/slot Slot # of Tele/
Screen Liner Dia From To width length slots pipe size

(8) WELL TESTS: Minimum testing time is 1 hour
[ ] Pump [ ] Bailer [ ] Air [ ] Flowing Artesian
Yield gal/min Drawdown Drill stem/Pump depth Duration (hr)

Temperature 54 °F Lab analysis [ ] Yes By
Water quality concerns? [ ] Yes (describe below) TDS amount 0 mg/L
From To Description Amount Units

(9) LOCATION OF WELL (legal description)
County WASHINGTON Twp 1.00 N N/S Range 3.00 W E/W WM
Sec 34 SW 1/4 of the SW 1/4 Tax Lot 3000
Tax Map Number Lot
Lat " or DMS or DD
Long " or DMS or DD
[ ] Street address of well [X] Nearest address

CITY WATER PARK, NEAR INTERSECTION OF CLARK ST AND 18TH AVE

(10) STATIC WATER LEVEL
Date SWL(psi) + SWL(ft)
Existing Well / Pre-Alteration
Completed Well
Flowing Artesian? [ ] Dry Hole? [ ]

Table for WATER BEARING ZONES with columns: SWL Date, From, To, Est Flow, SWL(psi), + SWL(ft)

(11) WELL LOG
Ground Elevation
Material From To

Date Started 3/20/2017 Completed 5/26/2017

(unbonded) Water Well Constructor Certification
I certify that the work I performed on the construction, deepening, alteration, or abandonment of this well is in compliance with Oregon water supply well construction standards. Materials used and information reported above are true to the best of my knowledge and belief.
License Number Date
Signed

(bonded) Water Well Constructor Certification
I accept responsibility for the construction, deepening, alteration, or abandonment work performed on this well during the construction dates reported above. All work performed during this time is in compliance with Oregon water supply well construction standards. This report is true to the best of my knowledge and belief.
License Number 1537 Date 6/9/2017
Signed SCOTT FLAHERTY (E-filed)
Contact Info (optional) Scott Flaherty 503.807.8611




WATER SUPPLY WELL REPORT - Map with location identified must be attached and shall include an approximate scale and north arrow

**WASH 75641**

6/9/2017

Map of Hole

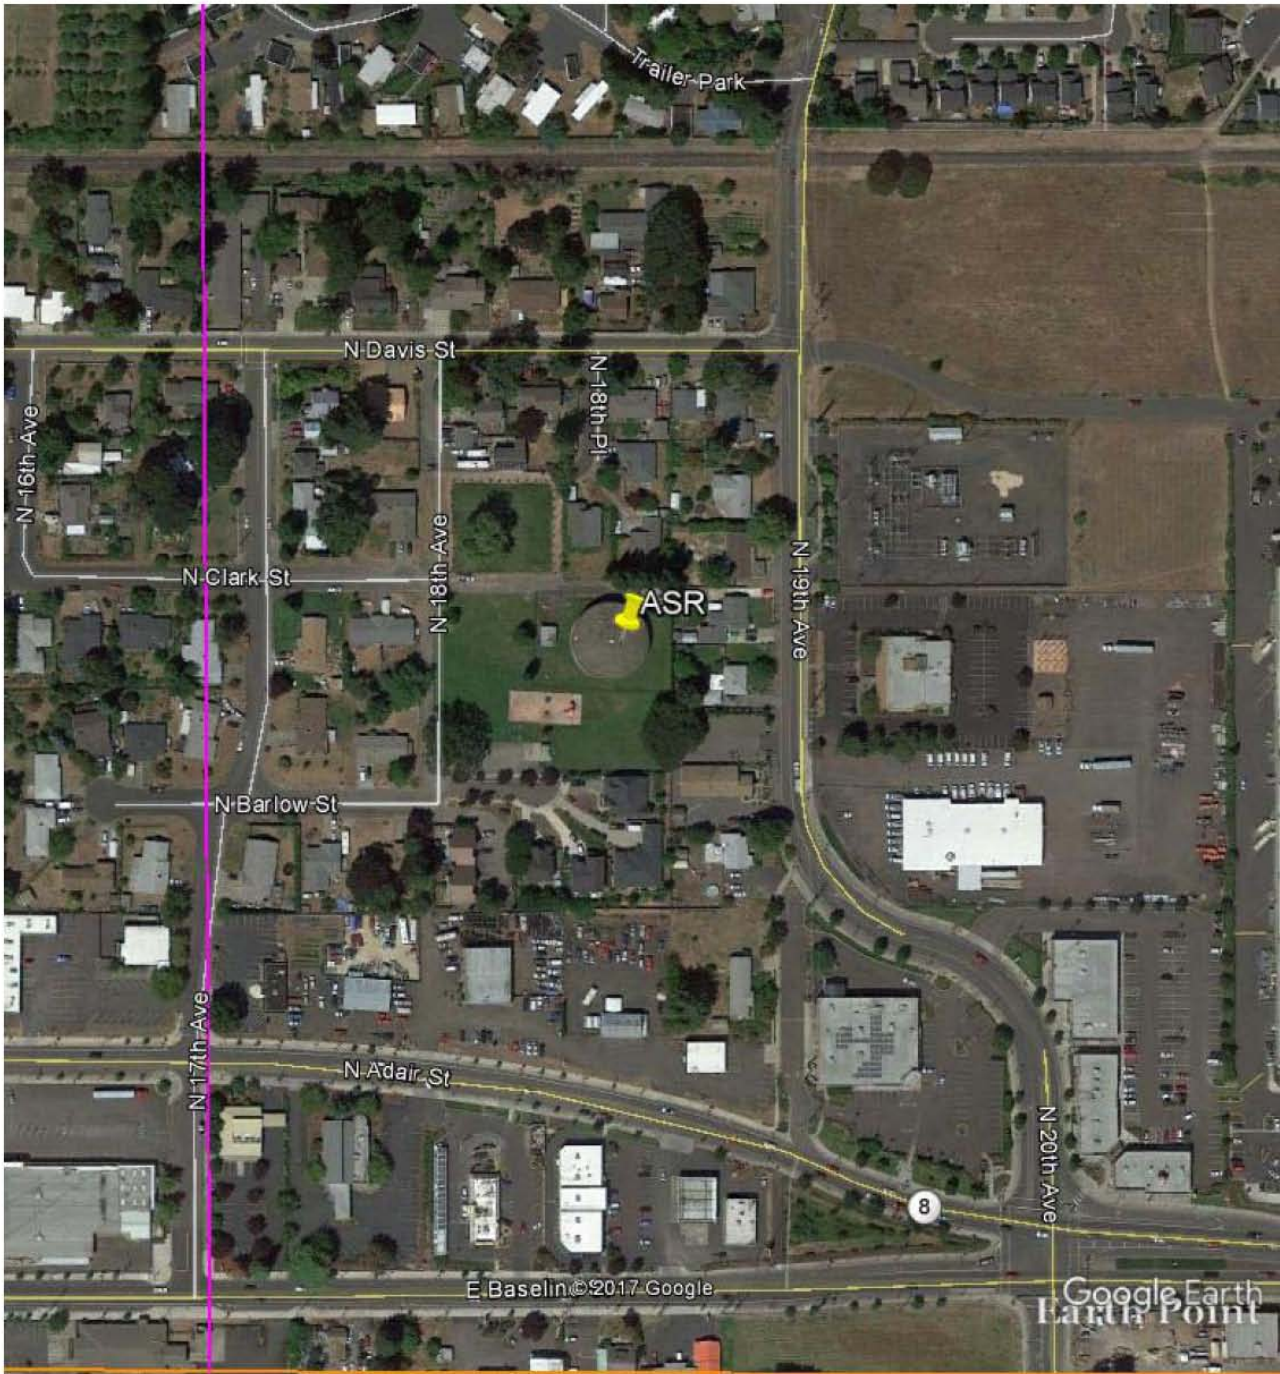

Google Earth

