


New exempt use wells must be submitted with a map and recording fee.

WATER SUPPLY WELL REPORT - Map with location identified must be attached and shall include an approximate scale and north arrow

WASH 83665

6/29/2026

Map of Hole

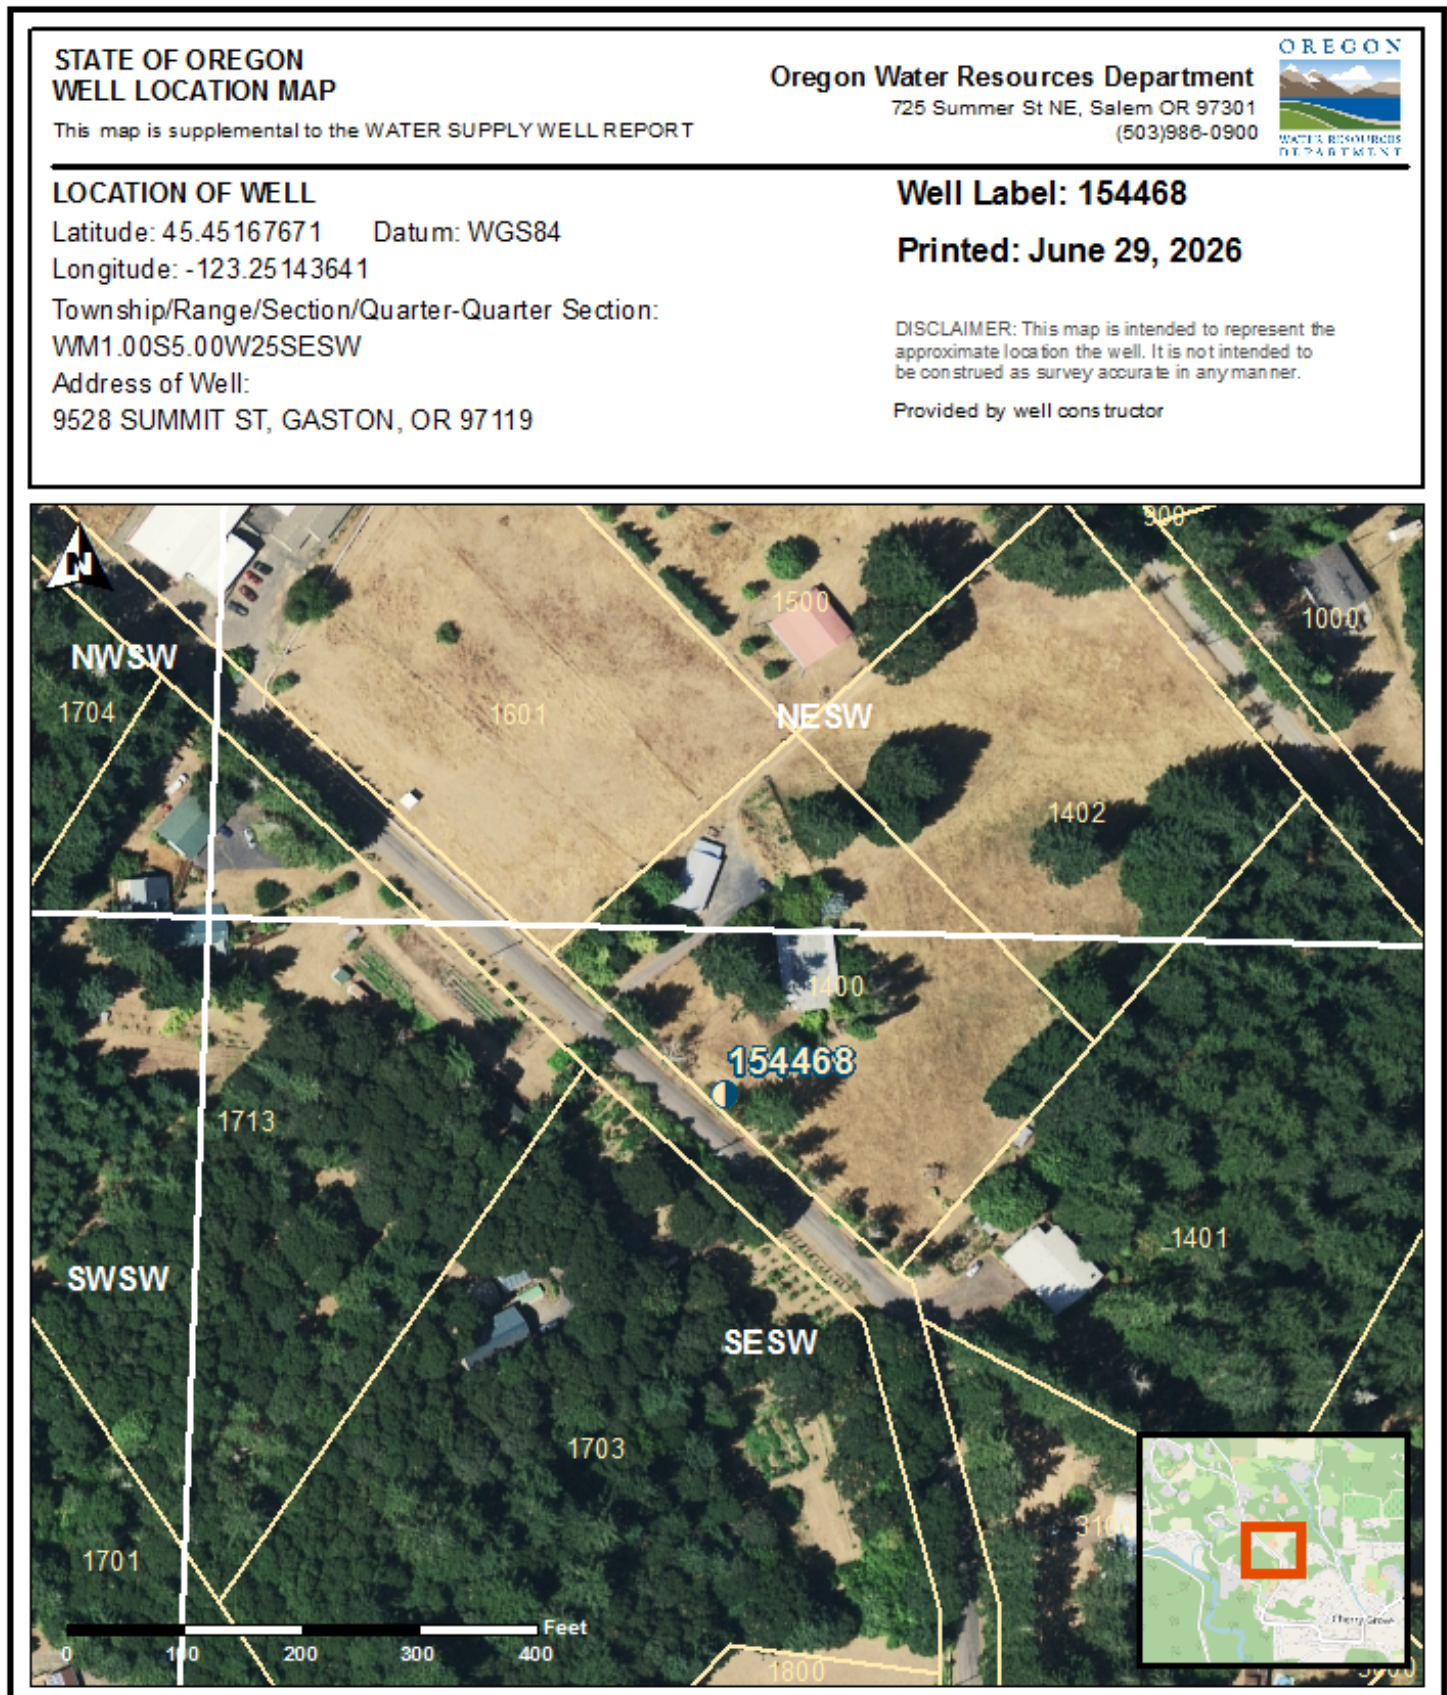

6/29/2026

Map of Hole

STATE OF OREGON
WELL LOCATION MAP

This map is supplemental to the WATER SUPPLY WELL REPORT

Oregon Water Resources Department

725 Summer St NE, Salem OR 97301
(503)986-0900

LOCATION OF WELL

Latitude: 45.45167671 Datum: WGS84

Longitude: -123.25143641

Township/Range/Section/Quarter-Quarter Section:

WM1.00S5.00W25SESW

Address of Well:

9528 SUMMIT ST, GASTON, OR 97119

Well Label: 154468

Printed: June 29, 2026

DISCLAIMER: This map is intended to represent the approximate location the well. It is not intended to be construed as survey accurate in any manner.

Provided by well constructor

