STATE OF OREGON
WATER SUPPLY WELL REPORT
(as required by ORS 537.545 & 537.765 and OAR 690-205-0210)

WASH 83885
10/8/2026

WELL I.D. LABEL# L 159749
START CARD # 1083642
ORIGINAL LOG #

(1) LAND OWNER

Owner Well I.D.
First Name DAVID & DIANA Last Name BRATTON
Company BRATTON, DAVID & DIANA TRUST
Address 22440 NW ARDABETH LANE
City BANKS State OR Zip 97106

(2) TYPE OF WORK

[X] New Well [ ] Deepening [ ] Conversion
[ ] Alteration (complete 2a & 10) [ ] Abandonment(complete 5a)

(2a) PRE-ALTERATION

	Dia	+	From	To	Gauge	Stl	Plstc	Wld	Thrd
Casing:									

	Material	From	To	Amt	sacks/lbs
Seal:					

(3) DRILL METHOD

[X] Rotary Air [ ] Rotary Mud [ ] Cable [ ] Auger
[ ] Reverse Rotary [ ] Other

(4) PROPOSED USE

[X] Domestic [ ] Irrigation [ ] Community
[ ] Industrial/ Commercial [ ] Livestock [ ] Dewatering
[ ] Thermal [ ] Injection [ ] Other

(5) BORE HOLE CONSTRUCTION

Special Standard [ ] (Attach copy)
Depth of Completed Well 145.00 ft.

BORE HOLE Dia	From	To	SEAL Material	From	To	Amt	sacks/lbs
10	0	18.5	Bentonite Chips	0	18.5	9	S
6	18.5	145			Calculated	8.44	
					Calculated		

Seal placement method: [ ] A [ ] B [ ] C [ ] D [ ] E [X] Other: POUR-PROBE-H2O
Backfill placed from ft. to ft. Material
Filter pack from ft. to ft. Material Size
Explosives used: [ ] Type Amount
Seal Placement Begin Date 9/29/2026 Begin Time 14 00

(5a) ABANDONMENT USING UNHYDRATED BENTONITE

Proposed Amount Actual Amount

(6) CASING/LINER

C/L	Dia	+	From	To	Gauge	Mat. Type	Wld	Thrd	Shoe	Shoe Location
C	6	X	1.5	18.5	0.250	ST	X		OUT.	18.5
L	4		5	85	Sch40	PL		X		
L	4		105	125	Sch40	PL		X		

Temp casing [X] Yes Dia 10 From + [X] 1 To 6

(7) PERFORATIONS/SCREENS

Perforations Method
Screens Type Machine Screen Material PVC

Perf/ Screen	Casing/ Liner	Screen Dia	From	To	Scrn/slot width	Slot length	# of slots	Tele/ Pipe size
Screen	Liner	4	85	105	.032			Pipe Size
Screen	Liner	4	125	145	.032			Pipe Size

(8) WELL TESTS: Minimum testing time is 1 hour

Type of Test	Yield (gal/min)	Drawdown	Drill Stem/ Pump Depth	Duration (hr)
Air	2		139	1

Temperature 54 °F Lab analysis [ ] Yes By
Water quality concerns? [ ] Yes (describe below) TDS amount 178 ppm

From	To	Description	Amount	Units

(9) LOCATION OF WELL (legal description)

County WASHINGTON Twp 2.00 N N/S Range 4.00 W E/W WM
Sec 4 SW 1/4 of the SE 1/4 Tax Lot 500
Tax Map Number Lot
Lat ° ' " or 45.68226526 DMS or DD
Long ° ' " or -123.18405211 DMS or DD
(•) Street address of well ( ) Nearest address
22440 NW ARDABETH LANE, BANKS, OR 97106

(10) STATIC WATER LEVEL

	Date	SWL(psi)	+	SWL(ft)
Existing Well / Pre-Alteration				
Completed Well	9/30/2026			16

Flowing Artesian? [ ] Dry Hole? [ ]

WATER BEARING ZONES Depth water was first found 6.00

SWL Date	From	To	Est Flow	SWL(psi)	+	SWL(ft)
9/29/2026	6	7	0.1			6
9/30/2026	40	100	2			16

(11) WELL LOG

Ground Elevation 276.84 FT

Material	From	To
Crushed Rock	0	1
Clay, Dense brown w/large river rock	1	7
Sandstone, Firm brown/red-brown mineralized	7	10
Siltstone, H gray	10	24
Siltstone, H gray w/ fine packed sand strata	24	140
Clay, Dense gray	140	145

Construction Begin Date 9/29/2026 Begin Time 08 45 End Date 9/30/2026

(unbonded) Water Well Constructor Certification

I certify that the work I performed on the construction, deepening, alteration, or abandonment of this well is in compliance with Oregon water supply well construction standards. Materials used and information reported above are true to the best of my knowledge and belief.

License Number Date

Signed

(bonded) Water Well Constructor Certification

I accept responsibility for the construction, deepening, alteration, or abandonment work performed on this well during the construction dates reported above. All work performed during this time is in compliance with Oregon water supply well construction standards. This report is true to the best of my knowledge and belief.

License Number 1977 Date 10/8/2026

Signed JOSE ESTRADA (E-filed)

Drilling Company: bluewaterdrilling@gmail.com 503-868-7878

WATER SUPPLY WELL REPORT - continuation page

WASH 83885

10/8/2026

WELL I.D. LABEL# L 159749
START CARD # 1083642
ORIGINAL LOG #

(2a) PRE-ALTERATION

Dia	+	From	To	Gauge	Stl	Plstc	Wld	Thrd

Material	From	To	Amt	sacks/lbs

(5) BORE HOLE CONSTRUCTION

BORE HOLE

Dia	From	To

SEAL

Material	From	To	Amt	sacks/lbs
		Calculated		
		Calculated		
		Calculated		
		Calculated		

FILTER PACK

From	To	Material	Size

(6) CASING/LINER

C/L	Dia	+	From	To	Gauge	Mat. Type	Wld	Thrd	Shoe	Shoe Location

(7) PERFORATIONS/SCREENS

Perf/ Screen	Casing/ Liner	Screen Dia	From	To	Scrn/slot width	Slot length	# of slots	Tele/ Pipe size

(8) WELL TESTS: Minimum testing time is 1 hour

Type of Test	Yield (gal/min)	Drawdown	Drill Stem/ Pump Depth	Duration (hr)

Water Quality Concerns

From	To	Description	Amount	Units

(10) STATIC WATER LEVEL

SWL Date	From	To	Est Flow	SWL(psi)	+	SWL(ft)

(11) WELL LOG

Material	From	To

Name of person(s) who assisted with construction and Trainee License # / Helper #

Assistant Name	Type	#
CHARLES ESTRADA	HELPER WATER	8888851

Comments/Remarks

WATER SUPPLY WELL REPORT - Map with location identified must be attached and shall include an approximate scale and north arrow

WASH 83885

10/8/2026

Map of Hole

STATE OF OREGON
WELL LOCATION MAP

This map is supplemental to the WATER SUPPLY WELL REPORT

Oregon Water Resources Department
725 Summer St NE, Salem OR 97301
(503)986-0900

LOCATION OF WELL

Latitude: 45.68226526 Datum: WGS84
Longitude: -123.18405211
Township/Range/Section/Quarter-Quarter Section:
WM2.00N4.00W4SWSE
Address of Well:
22440 NW ARDABETH LANE, BANKS, OR 97106

Well Label: 159749

Printed: October 7, 2026

DISCLAIMER: This map is intended to represent the approximate location the well. It is not intended to be construed as survey accurate in any manner.
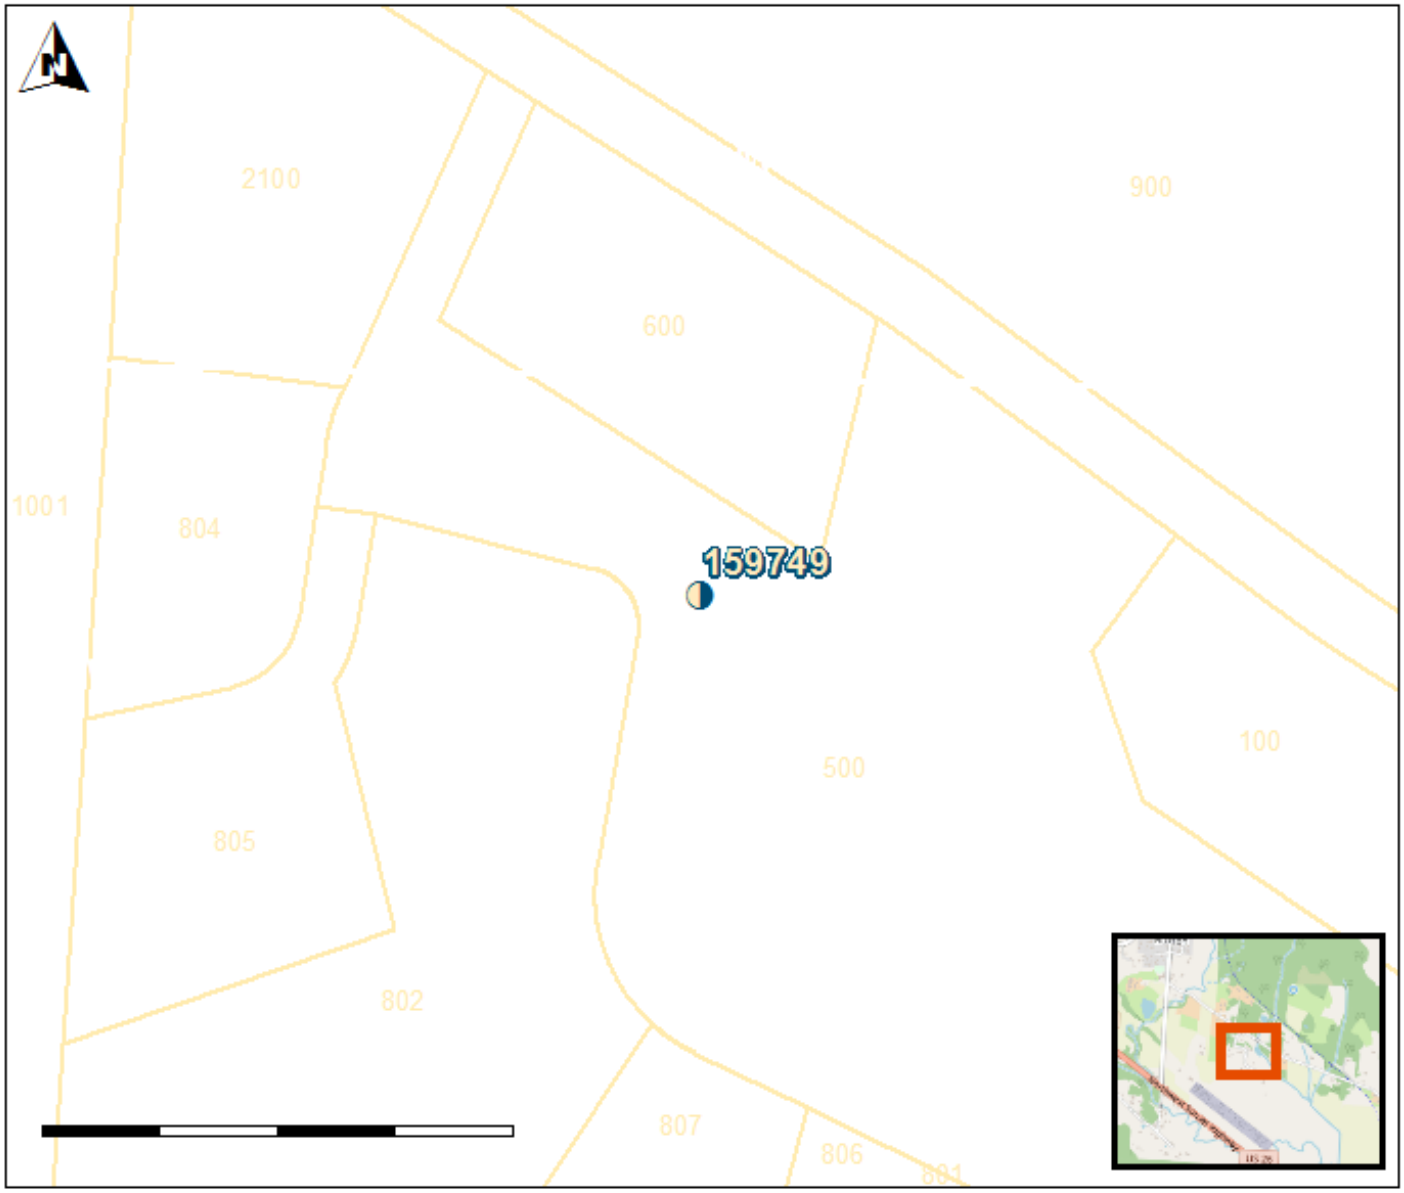
Provided by well constructor