

STATE ENGINEER
Salem, Oregon

WASH Well Record
008638

STATE WELL NO. 11W-100
COUNTY Washington
APPLICATION NO. GR-560

OWNER: Albert M. Thompson


MAILING ADDRESS: 15 SW Miller Rd. Pg 1 of 2

LOCATION OF WELL: Owner's No. 1

CITY AND STATE: Portland Oregon

NE 1/4 NW 1/4 Sec. 1 T. 1 S. R. 1 W., W.M.

Bearing and distance from section or subdivision
corner 490 ft. W. & 275 ft. S.
from N. 1/4 cor. of sec. 1

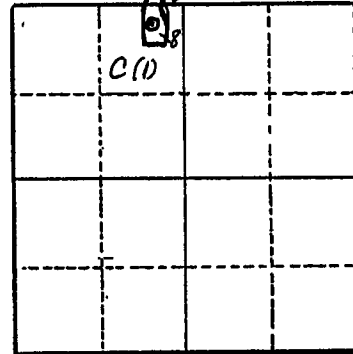

Altitude at well 835 feet Interpolated

TYPE OF WELL: Drilled Date Constructed Aug. 1951

Depth drilled 400 Depth cased 116

Section 1

CASING RECORD:

8 inch

FINISH:

AQUIFERS:

WATER LEVEL:

382

PUMPING EQUIPMENT: Type Submersible H.P. 10
Capacity 60 G.P.M.

WELL TESTS:

Drawdown 0 ft. after _____ hours 60 G.P.M.

Drawdown _____ ft. after _____ hours _____ G.P.M.

USE OF WATER irrigation - 16 Ac. Temp. _____ °F. _____ 19.

SOURCE OF INFORMATION GR-560

DRILLER or DIGGER _____

ADDITIONAL DATA:

Log X Water Level Measurements _____ Chemical Analysis _____ Aquifer Test _____

REMARKS:

