

STATE ENGINEER  
Salem, Oregon

WASH

008641

Well Record


STATE WELL NO. 1/1W-1Q(1)  
COUNTY Multnomah Wash  
APPLICATION NO. GR-725

OWNER: Wade Strowger, Pres. of Sunset Hills Mem. Park  
MAILING ADDRESS: Portland, Oregon

LOCATION OF WELL: Owner's No. #1  
CITY AND STATE: " "

SW 1/4 SE 1/4 Sec. 1 T. 1 S., R. 1 W., W.M.

Bearing and distance from section or subdivision corner Approx. 40' S. & 45' E. of initial pt. of Garden of Sunset Hills Mem. Park cemetery, which pt. bears from NE corner Wm. Pointer DLC. N89°05' 10" W. 1849' to a pt. then 0°23'20" E. 1442.78' to a pt. then ~~Altitude at well~~ S. 15°18'36" to said initial pt.

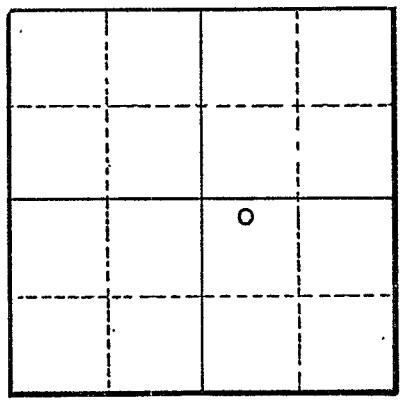

Section 3 (one)

TYPE OF WELL: Drilled Date Constructed 1932

Depth drilled 900' Depth cased

CASING RECORD:

5 (five) inch

~~XXXXXX~~ Altitude at well -- 750 ft.

AQUIFERS:

WATER LEVEL:

355 feet

PUMPING EQUIPMENT: Type C.S. Induction - Pomona 4 1/2" H.P. 10  
Capacity 60 G.P.M.

WELL TESTS:

Drawdown 15 ft. after 60 hours G.P.M.  
Drawdown ft. after hours G.P.M.

USE OF WATER Irrigation Temp. °F., 19

SOURCE OF INFORMATION GR- 725

DRILLER or DIGGER A.W. Janssen Drilling Co., Reedville

ADDITIONAL DATA:

Log None Water Level Measurements Chemical Analysis Aquifer Test

REMARKS: