

WASH.

STATE ENGINEER
Salem, Oregon

008648

Well Record

STATE WELL NO. VW-210
COUNTY Wash.
APPLICATION NO. GP-644

OWNER: J. R. Dant


MAILING ADDRESS: 8825 S.W. Barnes St

LOCATION OF WELL: Owner's No. 1

CITY AND STATE: Portland, Ore.

NE 1/4 SE 1/4 Sec. 2 T. 1 S., R. 1 W., W.M.

Bearing and distance from section or subdivision corner
S50°45' E. 588.0 FT. W.
of E. 1/4 cor. sec. 2.

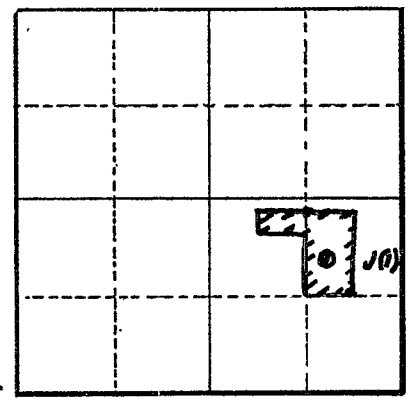

Altitude at well 490 (Approx.)

Section 2

TYPE OF WELL: Drilled Date Constructed April 10, '42

Depth drilled 907 Depth cased 777

CASING RECORD:
8 inch

FINISH:

AQUIFERS:

WATER LEVEL:

322 feet

PUMPING EQUIPMENT: Type Pacific H.P. 25
Capacity 80 G.P.M.

WELL TESTS:

Drawdown 60 ft. after _____ hours _____ 50 G.P.M.
Drawdown 120 ft. after _____ hours _____ 100 G.P.M.

USE OF WATER irrigation - 25.9 ac. Temp. _____ °F. _____, 19____

SOURCE OF INFORMATION GP-644

DRILLER or DIGGER R. J. Strasser, Portland, Ore.

ADDITIONAL DATA:

Log Water Level Measurements _____ Chemical Analysis _____ Aquifer Test _____

REMARKS:

