

STATE ENGINEER  
Salem, Oregon

WASH

# Well Record

STATE WELL NO. 1W-2 10)  
COUNTY Washington  
APPLICATION NO. GR-862


008651

OWNER: J Peter Kent / Calacorporation MAILING ADDRESS: 9755 SW Barnes Rd

LOCATION OF WELL: Owner's No. \_\_\_\_\_ CITY AND STATE: Beaverton

NE 1/4 SW 1/4 Sec. 2 T. 1 S., R. 1 W., W.M.

Bearing and distance from section or subdivision corner 1070' SW From SW Cor of NE 1/4 of Sect 2

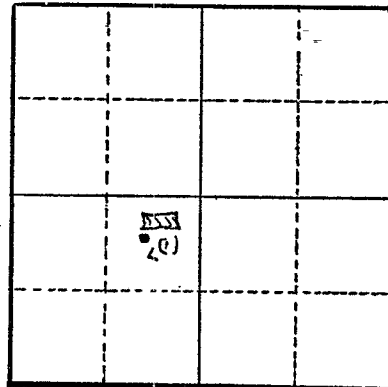

Section 2

Altitude at well 420'

TYPE OF WELL: Drilled Date Constructed May 1933

Depth drilled 208 Depth cased 200

### CASING RECORD:

8" dia 0' - 200'

### FINISH:

### AQUIFERS:

### WATER LEVEL:

90'

PUMPING EQUIPMENT: Type Kimball-Kraugh Deep Well Turbine P. 5 Elec  
Capacity 55 G.P.M. 1 phase

### WELL TESTS:

Drawdown \_\_\_\_\_ ft. after \_\_\_\_\_ hours 55 G.P.M.  
Drawdown \_\_\_\_\_ ft. after \_\_\_\_\_ hours \_\_\_\_\_ G.P.M.

USE OF WATER Greenhouse Irrigation Temp. \_\_\_\_\_ °F. \_\_\_\_\_, 19\_\_\_\_

### SOURCE OF INFORMATION

DRILLER or DIGGER A. L. Ziesing (deceased)

### ADDITIONAL DATA:

Log NA Water Level Measurements \_\_\_\_\_ Chemical Analysis \_\_\_\_\_ Aquifer Test \_\_\_\_\_

### REMARKS: