

STATE ENGINEER
Salem, Oregon

WASH
008653

Well Record

STATE WELL NO. W-2M
COUNTY Washington
APPLICATION NO. GR-863

OWNER: J Peter Kort & Co


MAILING ADDRESS: 9755 SW Barnes Rd

LOCATION OF WELL: Owner's No. _____

CITY AND STATE: Beaver Ton

NW 1/4 SW 1/4 Sec. 2 T. 1 S. R. 1 W., W.M.

Bearing and distance from section or subdivision
corner 500' NE of The Junction of
Barnes Road and Sunset Highway
1320' SE of SW Cor of NW 1/4
of Sec 2.

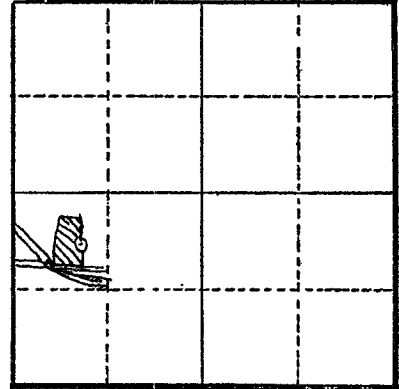

Section 2

Altitude at well 350

TYPE OF WELL: Drilled Date Constructed July 1947

Depth drilled 500' Depth cased 500'

CASING RECORD:

8" dia 0' - 500'

FINISH:

No Perforations

AQUIFERS:

WATER LEVEL:

120'

PUMPING EQUIPMENT: Type Coak deep well Turbine

H.P. 15 Elec

Capacity 100 G.P.M.

220 Volt 3 phase

WELL TESTS:

Drawdown 150 ft. after _____ hours 100 G.P.M.

Drawdown _____ ft. after _____ hours _____ G.P.M.

USE OF WATER Greenhouse Irrigation Temp. _____ °F. _____, 19

SOURCE OF INFORMATION Owner

DRILLER or DIGGER Al Ziesing

ADDITIONAL DATA:

Log AA Water Level Measurements _____ Chemical Analysis _____ Aquifer Test _____

REMARKS: