

STATE ENGINEER
Salem, Oregon
(Cedar Hills)

Well Record

WASH

STATE WELL NO. 11W-2P(1)
COUNTY Washington
APPLICATION NO. GR-242

008654

OWNER: C.H. Investment Corporation


MAILING ADDRESS: 200 Equitable Bldg.

LOCATION OF WELL: Owner's No. #1

CITY AND STATE: Portland, Oregon

SE 1/4 SW 1/4 Sec. 2 T. 1 S., R. 1 W., W.M.

Bearing and distance from section or subdivision corner 1475 feet east and 700 feet north from the SW corner of section 2.

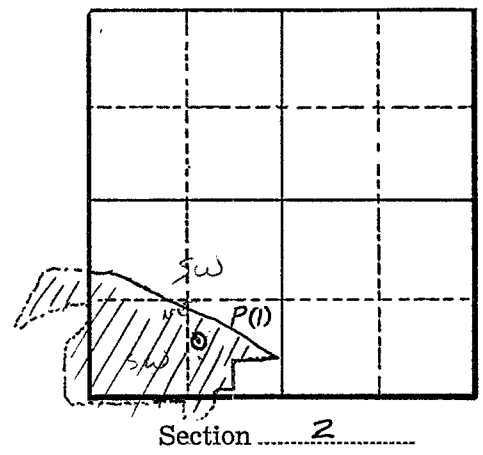

Altitude at well 419 feet Interpolated

TYPE OF WELL: Drilled Date Constructed 4-13-53

Depth drilled 875 Depth cased 728

CASING RECORD:

- 8 — 1 inch heavy gage casing set from 0 to 663 feet.
- 6 — " " gage " " " 663 to 728 feet

FINISH:

none - ?

AQUIFERS:

Basalts - 854 to 872 feet

WATER LEVEL:

242 feet below land surface Sept 21, 1953

PUMPING EQUIPMENT: Type Brown Jackson (16 stages) H.P. 20
Capacity 175 G.P.M.

WELL TESTS:

Drawdown 68 ft. after _____ hours pumping 175 G.P.M.
 Drawdown 97 ft. after _____ hours " 200 G.P.M.

USE OF WATER Irrigation & cooling 52 acres Temp. _____ °F., 19_____

SOURCE OF INFORMATION Registration Statement GR-242

DRILLER or DIGGER R.T. Strasser Drilling Co. 8110 SE Sansat Lane Portland, Ore.

ADDITIONAL DATA:

Log yes Water Level Measurements _____ Chemical Analysis _____ Aquifer Test _____

REMARKS:

STATE ENGINEER
Salem, Oregon

State Well No. W-270
County Washington Wash
Application No. GR-242

Well Log

Owner: C.H. Investment Corporation Owner's No. #1

Driller: R.J. Strasser Drilling Co. Date Drilled 4-13-53

CHARACTER OF MATERIAL	(Feet below land surface)		Thickness (feet)
	From	To	
Topsoil & clay	0	9	9
rock, broken	9	27	18
rock, medium hard gray	27	36	9
rock, hard gray	36	45	9
rock, hard gray basalt	45	109	64
rock, hard gray - broken crevices filled with brown seams	109	151	42
basalt, rough gray - crevices	151	158	7
basalt, hard grey	158	214	56
basalt, very hard gray	214	231	17
rock, broken brown conglomerate	231	239	8
clay, yellow	239	253	14
clay, blue	253	297	44
clay, blue	297	304	7
clay, yellow	304	316	12
clay, blue	316	329	13
clay, yellow	329	364	35
clay, blue	364	493	29
clay, red	493	527	34
clay, blue	527	593	66
clay, red	593	620	27
clay, yellow	620	627	7
conglomerate	627	673	46
rock, decomposed	673	717	44

64
663

Cont.

cont.

