

STATE ENGINEER
Salem, Oregon

WASH

Well Record


STATE WELL NO. 1/1W-6F
COUNTY WASHINGTON
APPLICATION NO. GR-2800

OWNER: Alan Moore 008740 MAILING ADDRESS: Rt. 2, 17980 W. Baseline Road

LOCATION OF WELL: Owner's No. CITY AND STATE: Beaverton, Oregon

SE 1/4 NW 1/4 Sec. 6 T. 1 N. 1 E. S, R. 1 W., W.M.

Bearing and distance from section or subdivision corner 1470' E. and 380' N.

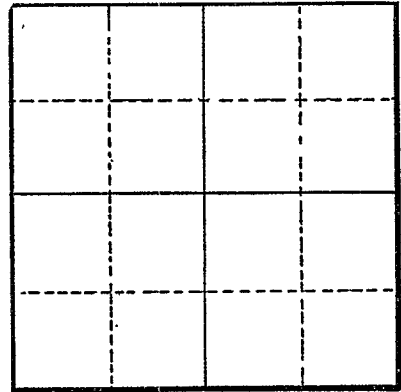

Section

Altitude at well

TYPE OF WELL: Bored Date Constructed 1950

Depth drilled 71 Depth cased 71

CASING RECORD:

12-inch

FINISH:

AQUIFERS:

WATER LEVEL:

3-feet

PUMPING EQUIPMENT: Type Peerless H.P. 1
Capacity 20 G.P.M.

WELL TESTS:

Drawdown ft. after hours G.P.M.
Drawdown ft. after hours G.P.M.

USE OF WATER irrigation Temp. °F. 19

SOURCE OF INFORMATION GR-2677

DRILLER or DIGGER

ADDITIONAL DATA:

Log Water Level Measurements Chemical Analysis Aquifer Test

REMARKS: