

STATE ENGINEER
Salem, Oregon


WASH Well Record

STATE WELL NO. 1/1W-6J
COUNTY Washington
APPLICATION NO. GR-3588

008743

OWNER: Howard E. Wilson MAILING ADDRESS: 16880 Baseline Rd.
CITY AND STATE: Beaverton, Oregon ?

LOCATION OF WELL: Owner's No. _____
NE 1/4 SE 1/4 Sec. 6 T. 1 S., R. 1 W., W.M.
Bearing and distance from section or subdivision
corner 890 ft. S. and 770 ft. W. of 1/4 cor. on E.
line of Sec. 6

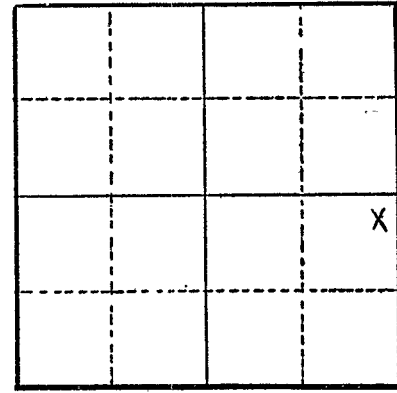

Section 6

Altitude at well _____

TYPE OF WELL: Drilled Date Constructed July, 1954

Depth drilled 240 ft. Depth cased 240 ft.

CASING RECORD:

6 inch diameter inside; 6 3/4 inch outside steel casing set to 240 feet

FINISH:

AQUIFERS:

WATER LEVEL:

20 feet below surface

PUMPING EQUIPMENT: Type Sears Jet electric H.P. 1
Capacity 20 G.P.M.

WELL TESTS:

Drawdown 20 ft. after _____ hours 20 G.P.M.
Drawdown _____ ft. after _____ hours _____ G.P.M.

USE OF WATER Irrigation Temp. _____ °F. _____, 19_____

SOURCE OF INFORMATION Well Registration Statement

DRILLER or DIGGER A. J. Gaunt

ADDITIONAL DATA:

Log _____ Water Level Measurements _____ Chemical Analysis _____ Aquifer Test _____

REMARKS:



Oregon Water Resources Department
 725 Summer Street NE, Suite A
 Salem Oregon 97301
 (503) 986-0900
 www.oregon.gov/owrd

Application for Well ID Number

RECEIVED

NOV 21 2024

Do not complete if the well already has a Well Identification Number.

OWRD

I. OWNER INFORMATION

Current Owner Name (please print): TriMet
 Mailing Address: 101 SW Main Street, Suite 700
 City, State, Zip: Portland, OR 97204
 Mail Well ID to: SAME AS ABOVE In Care Of (C/O)
 Name & Address: Mike Krzeminski - Manager, Environmental Services
 City, State, Zip: _____

II. WELL LOCATION INFORMATION (Please fill out as completely as possible)

Township: 1 S (North / South) Range: 1 W (East / West) Section: 6 NE 1/4 of the SE 1/4
 Tax Lot (usually last 3-5 numbers of Tax Map #): 300 County Washington
 GPS Coordinates: 45.510087, -122.849851
 Street Address of Well, City: 16250 SW Jenkins Road, Beaverton, OR 97006
 If the property had a different street address in the past: 16880 Baseline Road, Beaverton, OR

III. GENERAL WELL INFORMATION (Please fill out as completely as possible, AND attach copy of Well Report, if available)

Use of Well (domestic, irrigation, commercial, industrial, monitoring): Irrigation - Landscaping
 Date Well Constructed (or property built): July 1954 Total Well Depth: 240' Casing Diameter: 6"
 Owner at time the well was constructed (if known): Howard E. Wilson Well Report # (if known): WASH 8743
 Other Information: _____

SUBMITTED BY (please print): Mike Krzeminski - Manager, Environmental Services
 PHONE: 503-962-2472 EMAIL &/or FAX: krzemim@trimet.org

To send the completed application, you may MAIL it to: Oregon Water Resources Dept. 725 Summer St NE, Suite A, Salem, Oregon 97301.
 Or EMAIL the completed PDF form to: Ladeena.K.Ashley@water.oregon.gov, or FAX it to: (503) 986-0902.

For Official Use Only by the Oregon Water Resources Department:

Received Date: <u>11-21-2024</u>	Well Report Number: <u>WASH 8743</u>	Well Identification #: <u>L-156048</u>
-------------------------------------	---	---