

STATE ENGINEER  
Salem, Oregon

WASH  
008768

Well Record

STATE WELL NO. 1/1W-7D  
COUNTY WASHINGTON  
APPLICATION NO. GR-2681

OWNER: John E. Meeke


MAILING ADDRESS: 2100 SW 185th

LOCATION OF WELL: Owner's No.

CITY AND STATE: Aloha, Oregon

NW 1/4 NW 1/4 Sec. 7 T. 1 S., R. 1 W., W.M.

Bearing and distance from section or subdivision corner S. 20° 5' E. 640'

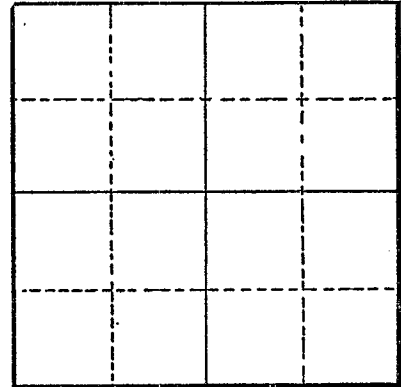

Section

Altitude at well

TYPE OF WELL: drilled Date Constructed 1945

Depth drilled 90 Depth cased 82

CASING RECORD:

6-inch

FINISH:

AQUIFERS:

Clay and sand

WATER LEVEL:

5-feet

PUMPING EQUIPMENT: Type Pacific jet H.P. 1/2  
Capacity 45 G.P.M.

WELL TESTS:

Drawdown 75 ft. after hours Pumping 300 G.P.M.  
Drawdown ft. after hours G.P.M.

USE OF WATER irrigation Temp. °F., 19

SOURCE OF INFORMATION GR-2540

DRILLER or DIGGER

ADDITIONAL DATA:

Log X Water Level Measurements Chemical Analysis Aquifer Test

REMARKS:

Clay 82  
Blue sand 8