

STATE ENGINEER
Salem, Oregon

WASH
008770

Well Record

STATE WELL NO. 1/1W-7E
COUNTY WASHINGTON
APPLICATION NO. GR-2427

OWNER: George Geiger, Georgia Geiger


MAILING ADDRESS: Aloha

LOCATION OF WELL: Owner's No.

CITY AND STATE: Oregon

SE 1/4 NW 1/4 Sec. 7 T. 1 S., R. 1 W., W.M.

Bearing and distance from section or subdivision corner About 490' W and 50' N from center of Section 7

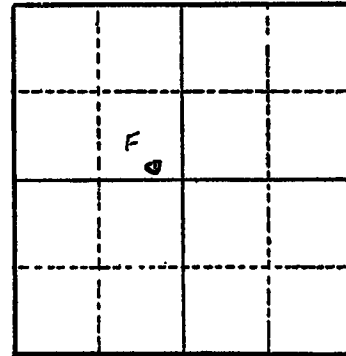

Altitude at well

TYPE OF WELL: Drilled Date Constructed 1949

Depth drilled 115' Depth cased 115

Section 7

CASING RECORD:

6-inch

FINISH:

AQUIFERS:

Top soil, Hard clay, Blue clay, Sandstone

WATER LEVEL:
75'

PUMPING EQUIPMENT: Type Johnson Jet

H.P. 1

Capacity 18 G.P.M.

WELL TESTS:

Drawdown None ft. after hours 18 G.P.M.

Drawdown None ft. after hours 18 G.P.M.

USE OF WATER Irrigation

Temp. °F. 19.

SOURCE OF INFORMATION GR-3875

DRILLER or DIGGER

ADDITIONAL DATA:

Log Water Level Measurements Chemical Analysis Aquifer Test

REMARKS: Top soil 1' to 114'
Hard clay 20' to 94'
Blue clay 86' to 8'
Sandstone 9' to water