

STATE ENGINEER
Salem, Oregon

WASH Well Record

STATE WELL NO. W-1000
COUNTY Wash.
APPLICATION NO. CR-564

OWNER: Truman W. Collins

MAILING ADDRESS: 11695 S.W. Lynnridge St.


LOCATION OF WELL: Owner's No. _____

CITY AND STATE: Beaverton, Ore.

NE 1/4 NW 1/4 Sec. 10 T. 1 S., R. 1 W., W.M.

Bearing and distance from section or subdivision

corner 1700 Ft W. & 2050 Ft. N.
of Antonia C. Lassen D.L.C.

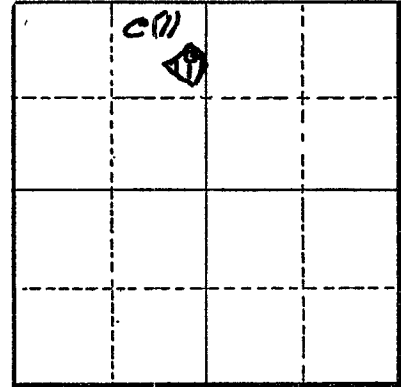

Section 10

Altitude at well 370

TYPE OF WELL: drilled Date Constructed 1940-'42

Depth drilled 600 Depth cased 115

CASING RECORD:

6 inch

FINISH:

AQUIFERS:

WATER LEVEL:

10-20 ft.

PUMPING EQUIPMENT: Type Pacific Turbine H.P. 10

Capacity 80 G.P.M.

WELL TESTS:

Drawdown ft. after hours G.P.M.

Drawdown ft. after hours G.P.M.

USE OF WATER irrigation - 28 Ac. Temp. °F., 19.....

SOURCE OF INFORMATION CR-564

DRILLER or DIGGER Harty Bros. ; Portland, Ore.

ADDITIONAL DATA:

Log Water Level Measurements Chemical Analysis Aquifer Test

REMARKS: