

STATE ENGINEER
Salem, Oregon

WASH

Well Record

STATE WELL NO. 1/1W-11M
COUNTY ~~Washington~~ Washington
APPLICATION NO. GR-3501

008787

OWNER: Northwestern Christian Home


MAILING ADDRESS: 3400 SW 103rd Ave.

LOCATION OF WELL: Owner's No.

CITY AND STATE: Oregon

NW 1/4 SW 1/4 Sec. 11 T. 1 N. S, R. 1 W, W.M.

Bearing and distance from section or subdivision
corner 1882 feet South 24°24' West to SW Corner,
Section 11

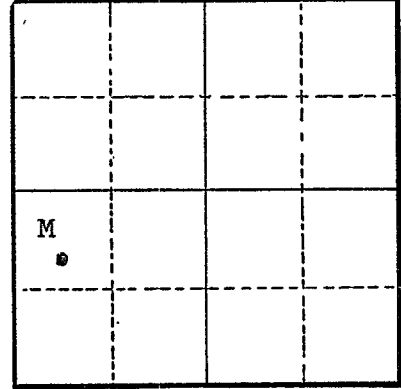

Section 11

Altitude at well 190 feet

TYPE OF WELL: Drilled Date Constructed July 1946

Depth drilled 276 feet Depth cased

CASING RECORD:

FINISH:

AQUIFERS:

WATER LEVEL:
50 feet

PUMPING EQUIPMENT: Type 32 H Peerless High Lift H.P. 5
Capacity 50 G.P.M.

WELL TESTS:

Drawdown	no	ft. after	hours	19	G.P.M.
Drawdown		ft. after	hours	20	G.P.M.

USE OF WATER non-drinking & Irrigation Temp. °F. , 19

SOURCE OF INFORMATION GR-4040

DRILLER or DIGGER A. M. Janssen Co. Aloha, Oregon

ADDITIONAL DATA:

Log (NA) Water Level Measurements Chemical Analysis Aquifer Test

REMARKS:

may be in 1N/1W-11M(i)
on 2741 Westover Rd
according to USGS log