

STATE ENGINEER  
Salem, Oregon

# WASH OBSERVATION WELL Well Record

STATE WELL NO. 11-1160  
COUNTY Washington  
APPLICATION NO. GR-343


008791

OWNER: City of Beaverton - by R.O. Malsey MAILING ADDRESS: City Hall

LOCATION OF WELL: Owner's No. #1 CITY AND STATE: Beaverton, Oregon

NE 1/4 SW 1/4 Sec. 11 T. 1 S., R. 1 W., W.M.

Bearing and distance from section or subdivision corner 2550 feet east and 220 feet south from W 1/4 corner of section 11.

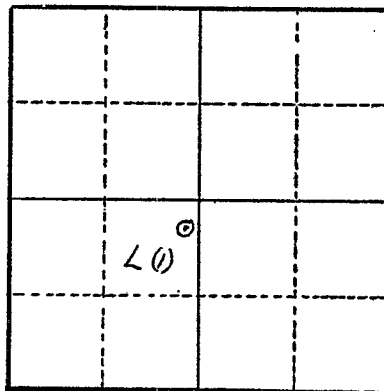

Section 11

Altitude at well 360 feet Interpolated

TYPE OF WELL: Drilled Date Constructed 1932

Depth drilled 825 Depth cased 609.9

### CASING RECORD:

10 inch casing set from 0 to 215.4 feet.  
8 inch " " " 215.4 to 609.9 feet.

### FINISH:

unknown

### AQUIFERS:

rock - 650 to 735 feet ?

### WATER LEVEL:

180 feet below land surface. 1932

PUMPING EQUIPMENT: Type Pamona Deep Well Turbine H.P. 40  
Capacity 500 G.P.M.

### WELL TESTS:

Drawdown 40 ft. after \_\_\_\_\_ hours pumping? G.P.M.  
Drawdown \_\_\_\_\_ ft. after \_\_\_\_\_ hours \_\_\_\_\_ G.P.M.

USE OF WATER Washington Municipal Yeager Temp. \_\_\_\_\_ °F. \_\_\_\_\_ 19 \_\_\_\_\_

SOURCE OF INFORMATION Rep. Statement GR-343

DRILLER or DIGGER \_\_\_\_\_

### ADDITIONAL DATA:

Log yes Water Level Measurements \_\_\_\_\_ Chemical Analysis \_\_\_\_\_ Aquifer Test \_\_\_\_\_

### REMARKS:

