

STATE ENGINEER  
Salem, Oregon

WASH

Well Record

STATE WELL NO. 111W-13N  
COUNTY Washington  
APPLICATION NO. GR-2105

OWNER: Portland Golf Club  
George B. North

008801


MAILING ADDRESS: 5900 S.W. Scholls Ferry Rd.

LOCATION OF WELL: Owner's No. #1

CITY AND STATE: Portland, Oregon

SW 1/4 SW 1/4 Sec. 13 T. 1 N. S., R. 1 E. W., W.M.

Bearing and distance from section or subdivision corner N 22° 30' E 900'

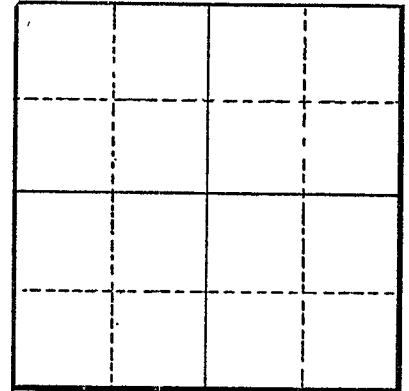

Section .....

Altitude at well .....

TYPE OF WELL: Drilled Date Constructed 1936

Depth drilled 515 Depth cased 200

CASING RECORD:

12 - inch

FINISH:

AQUIFERS:

WATER LEVEL:

36 - Feet

PUMPING EQUIPMENT: Type Byron JACKSON H.P. 30  
Capacity 200 G.P.M.

WELL TESTS:

Drawdown 300 ft. after ..... hours Pumping 200 G.P.M.  
Drawdown ..... ft. after ..... hours ..... G.P.M.

USE OF WATER Irrigation Temp. ..... °F. ...., 19.....

SOURCE OF INFORMATION GR-2023

DRILLER or DIGGER JAMSEN, Salem, Oregon

ADDITIONAL DATA:  
Log ..... Water Level Measurements ..... Chemical Analysis ..... Aquifer Test .....

REMARKS: