

STATE ENGINEER  
Salem, Oregon

WASH

# Well Record

STATE WELL NO. 1/1W-17A  
COUNTY Washington  
APPLICATION NO. GR-1299

GR-1256


008848

OWNER: Sisters of St. Mary of Oregon MAILING ADDRESS: 4440 SW 148th Ave.

LOCATION OF WELL: Owner's No. #1 CITY AND STATE: Beaverton, Oregon

NE 1/4 NE 1/4 Sec. 17 T. 1 S., R. 1 W., W.M.

Bearing and distance from section or subdivision corner 1280' S37°30'W. from NE cor. Sec. 17

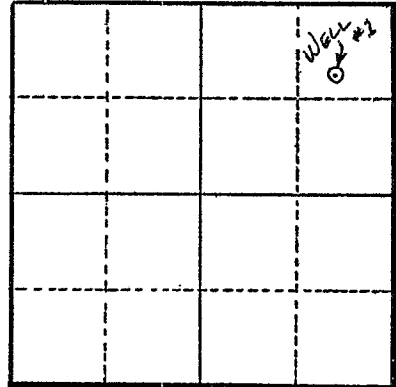

Section 17

Altitude at well 200 ft.

TYPE OF WELL: Drilled Date Constructed 1935

Depth drilled 212 ft. Depth cased

### CASING RECORD:

6 inch

### FINISH:

### AQUIFERS:

### WATER LEVEL:

PUMPING EQUIPMENT: Type Dering turbine H.P. 5

Capacity 30 G.P.M.

### WELL TESTS:

Drawdown 30 ft. after 30 hours G.P.M.

Drawdown ft. after hours G.P.M.

USE OF WATER Dom. & Irrigation Temp. °F. 19

SOURCE OF INFORMATION G. R. Record

DRILLER or DIGGER Ole Olson

### ADDITIONAL DATA:

Log N.A. Water Level Measurements Chemical Analysis Aquifer Test

### REMARKS:

Irrigation of 4.5 acres.