

STATE ENGINEER
Salem, Oregon

WASH
008849

Well Record

STATE WELL NO. 1/1W-17A(2)
COUNTY Washington
APPLICATION NO. GR-1300


GR-1257

OWNER: Sisters of St. Mary of Oregon MAILING ADDRESS: 4440 SW 148th Ave.

LOCATION OF WELL: Owner's No. #2 CITY AND STATE: Beaverton, Oregon

NE 1/4 NE 1/4 Sec. 17 T. 1 S. R. 1 W., W.M.

Bearing and distance from section or subdivision corner 970' S7°W. of NE cor. Sec. 17.

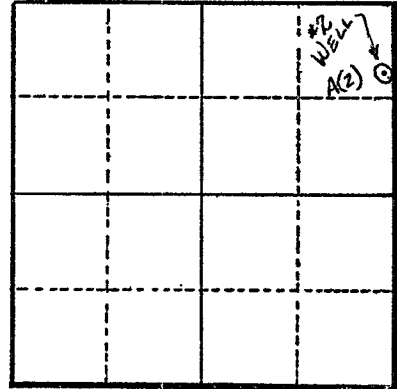

Section 17

Altitude at well 200 ft.

TYPE OF WELL: Drilled Date Constructed 1954

Depth drilled 215 ft. Depth cased 205 ft.

CASING RECORD:

22 inch from 0 to 42 ft.
8 inch from 42 to 205 ft.

FINISH:

AQUIFERS:

WATER LEVEL:

52 ft.

PUMPING EQUIPMENT: Type Pacific submersible H.P. 5

Capacity 45 G.P.M.

WELL TESTS:

Drawdown 195 ft. after (1954) hours 45 G.P.M.

Drawdown 195 ft. after (1958) hours 30 G.P.M.

USE OF WATER Dom. & Irrigation Temp. °F. 19

SOURCE OF INFORMATION G. R. Record

DRILLER or DIGGER A. M. Janssen

ADDITIONAL DATA:

Log Water Level Measurements Chemical Analysis Aquifer Test

REMARKS:

Log: Brown clay 0 to 18 ft.
Blue & brown clay 18 to 190 ft.
Blue sand (water) 190 to 200 ft.
Blue clay & sand 200 to 205 ft.
Blue sand (water) 205 to 210 ft.
Blue clay 210 to 215 ft.

Irrigation of 4.5 acres.