

STATE ENGINEER
Salem, Oregon

WASH

Well Record

STATE WELL NO. 1/1W-17H
COUNTY Washington
APPLICATION NO. GR-1301

008853 GR 1258

OWNER: Sisters of St. Mary of Oregon


MAILING ADDRESS: 4440 SW 148th Ave.

LOCATION OF WELL: Owner's No. #3

CITY AND STATE: Beaverton, Oregon

SE 1/4 NE 1/4 Sec. 17 T. 1 S, R. 1 W., W.M.

Bearing and distance from section or subdivision corner 1400' S12°W. from NE cor. Sec. 17

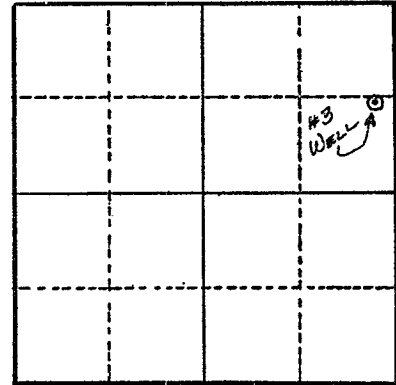

Section 17

Altitude at well

TYPE OF WELL: Drilled Date Constructed 1935

Depth drilled 210 ft. Depth cased 210 ft.

CASING RECORD:

6 inch

FINISH:

AQUIFERS:

WATER LEVEL:

90 ft.

PUMPING EQUIPMENT: Type Deming Deep Well Turbine H.P. 5

Capacity 50 G.P.M.

WELL TESTS:

Drawdown 160 ft. after 50 hours G.P.M.

Drawdown ft. after hours G.P.M.

USE OF WATER Dom. & Irrigation Temp. °F. 19

SOURCE OF INFORMATION G. R. Record

DRILLER or DIGGER Ole Olson

ADDITIONAL DATA:

Log N.A. Water Level Measurements Chemical Analysis Aquifer Test

REMARKS:

Irrigation of 4.2 acres.