

STATE ENGINEER
Salem, Oregon

WASH

Well Record

STATE WELL NO. 11W-18D
COUNTY WASHINGTON
APPLICATION NO. GR-1807

GR-1748

008879

OWNER: HEWETT WARRENS


MAILING ADDRESS: 4090 S.W. 185TH

LOCATION OF WELL: Owner's No.

CITY AND STATE: ALOHA, ORE.

NW 1/4 NW 1/4 Sec. 18 T. 1 S., R. 1 W., W.M.

Bearing and distance from section or subdivision corner 660' S. & 300' E. FROM NW COR SEC. 18

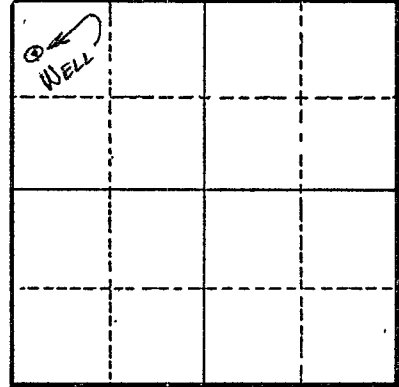

Section 18

Altitude at well 200'

TYPE OF WELL: Dug Date Constructed 1930

Depth drilled 27' Depth cased 27'

CASING RECORD:

6' - BRICK

FINISH:

AQUIFERS:

WATER LEVEL:

2' - WINTER
19' - FALL

PUMPING EQUIPMENT: Type HOMART JET H.P. 1

Capacity 25.4 G.P.M.

WELL TESTS:

Drawdown 4 ft. after 1 hours 14.4 G.P.M.

Drawdown ft. after hours G.P.M.

USE OF WATER IRRIGATION Temp. °F. 19

SOURCE OF INFORMATION G.R. RECORD

DRILLER or DIGGER

ADDITIONAL DATA:

Log M.A. Water Level Measurements Chemical Analysis Aquifer Test

REMARKS:

IRRIGATION OF 1 ACRE.