

STATE ENGINEER
Salem, Oregon

WASH

Well Record

STATE WELL NO. 1/1W-18K
COUNTY Washington
APPLICATION NO. GR-3533


008882

OWNER: Anton G. Hauptman MAILING ADDRESS: 5085 SW 173 Avenue

LOCATION OF WELL: Owner's No. CITY AND STATE: Oregon

NW 1/4 SE 1/4 Sec. 18 T. 1 S., R. 1 W., W.M.

Bearing and distance from section or subdivision corner 770 feet South and 550 feet East from the center of Section 18.

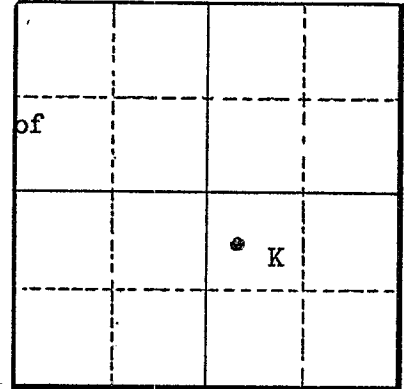

Section 18

Altitude at well 50 to 60 feet

TYPE OF WELL: Drilled Date Constructed May '42

Depth drilled 113 feet Depth cased 110 feet

CASING RECORD:

4-inch casing set from 0 to 110 feet

FINISH:

No perforations

AQUIFERS:

Water bearing sand

WATER LEVEL:

30 feet

PUMPING EQUIPMENT: Type Jacuzzi H.P. Capacity G.P.M.

WELL TESTS:

Drawdown ft. after hours G.P.M.
Drawdown ft. after hours G.P.M.

USE OF WATER Irrigation Temp. °F., 19

SOURCE OF INFORMATION GR-4052

DRILLER or DIGGER A. J. Gaunt Aloha, Oregon

ADDITIONAL DATA:

Log Water Level Measurements Chemical Analysis Aquifer Test

REMARKS:

Water bearing sand from 110 to 113 feet

Well location: 153 feet West and 15 feet North from the SE Corner, of the N 1/2 Lot 336, Johnson Estate Addition.