

STATE ENGINEER
Salem, Oregon

WASH

Well Record

STATE WELL NO. 1/1W-18P
COUNTY Washington
APPLICATION NO. GR-3252

008886


OWNER: Gerald B. Gray

MAILING ADDRESS: P. O. Box 5197

CITY AND STATE: Aloha, Oregon

LOCATION OF WELL: Owner's No. _____
(Sec. 7) SE SW 7
(Sec. 18) NE 1/4 NW 1/4 Sec. 18 T. 1 N. S., R. 1 E. W., W.M.

Bearing and distance from section or subdivision corner 380' W. and 30' N. of 1/4 cor. on South line Sec. 7

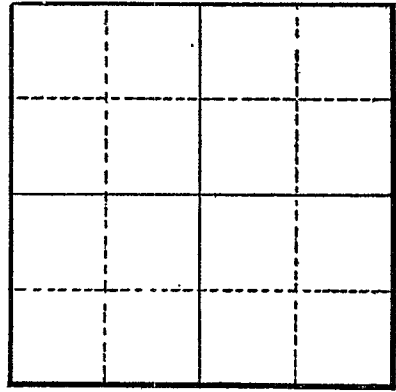

Section _____

Altitude at well _____

TYPE OF WELL: drilled Date Constructed 1946

Depth drilled 108 Depth cased 91

CASING RECORD:

6 inch

FINISH:

5" perforated liner from 89 to 108

AQUIFERS:

WATER LEVEL:

18 feet

PUMPING EQUIPMENT: Type Meyers Ejecto H.P. 1
Capacity 10 G.P.M.

WELL TESTS:

Drawdown _____ ft. after _____ hours _____ G.P.M.
Drawdown _____ ft. after _____ hours _____ G.P.M.

USE OF WATER Irrigation Temp. _____ °F. _____, 19

SOURCE OF INFORMATION GR-3026

DRILLER or DIGGER Paul E. Ross 2040 SW 192nd Ave., Aloha, Oregon

ADDITIONAL DATA:

Log _____ Water Level Measurements _____ Chemical Analysis _____ Aquifer Test _____

REMARKS: