

STATE ENGINEER
Salem, Oregon

008913

WASH


Well Record

STATE WELL NO. 1/1W-19J
COUNTY Washington
APPLICATION NO. GR-3194

OWNER: Lewis C. Martin
MAILING ADDRESS: 5350 SW Rigert Road
CITY AND STATE: Beaverton, Oregon

LOCATION OF WELL: Owner's No. _____
NE 1/4 SE 1/4 Sec. 19 T. 1 N. S. R. 1 E. W., W.M.

Bearing and distance from section or subdivision
corner 1000 feet West and 1740 feet North from the SE Corner,
Section 19.

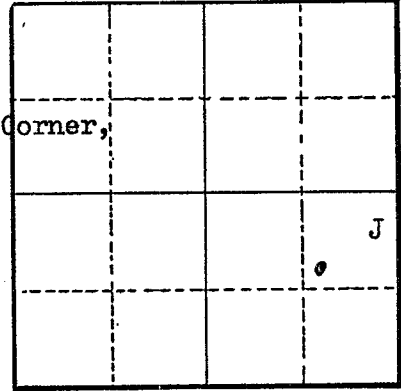

Altitude at well 340 feet

TYPE OF WELL: Drilled Date Constructed 7-12-46
Depth drilled 253 feet Depth cased 72.6 feet

Section 19

CASING RECORD:

6-inch casing set from surface to 72.6 feet

FINISH:

a coupling for drive shoot no perforations

AQUIFERS:

clay, rock, and brown lava

WATER LEVEL:

116 feet

PUMPING EQUIPMENT: Type Fairbanks Morse Deep Well 9 in head H.P.
Capacity 10 G.P.M.

WELL TESTS:

Drawdown 55 ft. after 10 hours G.P.M.
Drawdown _____ ft. after _____ hours G.P.M.

USE OF WATER Irrigation Temp. _____ °F., 19

SOURCE OF INFORMATION GR-4096

DRILLER or DIGGER _____

ADDITIONAL DATA:

Log Water Level Measurements _____ Chemical Analysis _____ Aquifer Test _____

REMARKS:

clay 70 ~~70~~ 0 to 70
gray basalt rock 180 ~~250~~ 70 to 250
brown lava 3 ~~1~~ 250 to 253