

STATE ENGINEER  
Salem, Oregon

WASH  
008915

# Well Record

STATE WELL NO. 1/LW-19-J  
COUNTY WASHINGTON  
APPLICATION NO. GR-2376

OWNER: Edna E. Barron


MAILING ADDRESS: 16595 S.W. Hart Road

LOCATION OF WELL: Owner's No.

CITY AND STATE: Beaverton, Oregon

NE 1/4 SE 1/4 Sec. 19 T. 1 S., R. 1 W., W.M.

Bearing and distance from section or subdivision corner 1750' N. 7° 30' W.

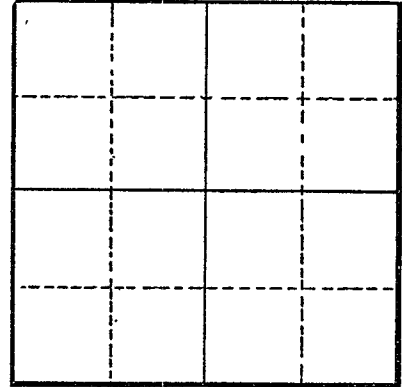

Section

Altitude at well

TYPE OF WELL: Drilled. Date Constructed 1944

Depth drilled 301 Depth cased 223

### CASING RECORD:

6-inch

### FINISH:

### AQUIFERS:

### WATER LEVEL:

79-feet

PUMPING EQUIPMENT: Type Peerless Turbine H.P. 7 1/2  
Capacity 120 G.P.M.

### WELL TESTS:

Drawdown 145 ft. after hours Pumping 100 G.P.M.  
Drawdown ft. after hours G.P.M.

USE OF WATER Irrigation Temp. °F., 19

SOURCE OF INFORMATION GR-2258

DRILLER or DIGGER Frances Livermore, Rt. 1, Beaverton, Oregon

### ADDITIONAL DATA:

Log Water Level Measurements Chemical Analysis Aquifer Test

### REMARKS: