

STATE ENGINEER
Salem, Oregon

WASH

Well Record

STATE WELL NO. 1/EW-19K
COUNTY WASHINGTON
APPLICATION NO. GR-2789


008917

OWNER: Arvin A. Burnett MAILING ADDRESS: 17495 S.W. Rigert Road

LOCATION OF WELL: Owner's No. CITY AND STATE: Beaverton, Oregon

NW 1/4 SE 1/4 Sec. 19 T. 1 N. S, R. 1 E. W., W.M.

Bearing and distance from section or subdivision corner 2700' NW of SE cor. of Sec. 19

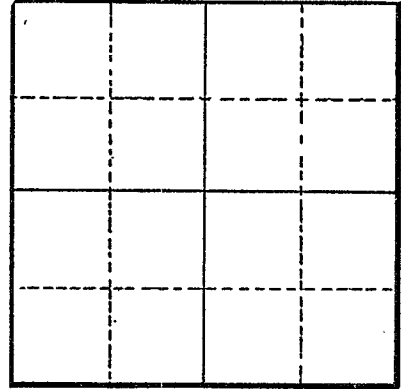

Section

Altitude at well

TYPE OF WELL: drilled Date Constructed 1954

Depth drilled 283 Depth cased 75

CASING RECORD:

6-inch I. D.

FINISH:

AQUIFERS:

Soil, rock and basalt

WATER LEVEL:

150-feet

PUMPING EQUIPMENT: Type Pacific submersible H.P. 1

Capacity 16 1/2 G.P.M.

WELL TESTS:

Drawdown nominal ft. after hours Pumping 15 G.P.M.

Drawdown ft. after hours G.P.M.

USE OF WATER irrigation Temp. °F., 19

SOURCE OF INFORMATION GR-2636

DRILLER or DIGGER Jack Barron, 16425 SW Hart Road, Beaverton, Oregon

ADDITIONAL DATA:

Log X Water Level Measurements Chemical Analysis Aquifer Test

REMARKS:

Soil and soft rock 120
Rock and basalt 163