

OWNER: Henry L. Burns


MAILING ADDRESS: Rt. 1 Box 1162

LOCATION OF WELL: Owner's No. \_\_\_\_\_

CITY AND STATE: Beaverton, Ore.

SE 1/4 SW 1/4 Sec. 19 T. 1 S., R. 1 W., W.M.

Bearing and distance from section or subdivision corner 1800 Ft. from S.W. cor. of sec. 19

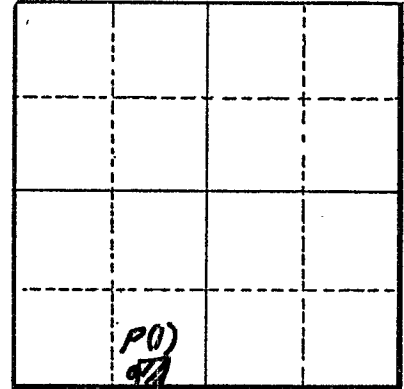

Altitude at well 430 feet

TYPE OF WELL: drilled Date Constructed Oct-'53

Depth drilled 292 Depth cased 90

Section 19

CASING RECORD:

6 inch

FINISH:

AQUIFERS:

WATER LEVEL:

210

PUMPING EQUIPMENT: Type F.M. submersible H.P. 1  
Capacity 15 G.P.M.

WELL TESTS:

Drawdown \_\_\_\_\_ ft. after \_\_\_\_\_ hours \_\_\_\_\_ G.P.M.  
Drawdown \_\_\_\_\_ ft. after \_\_\_\_\_ hours \_\_\_\_\_ G.P.M.

USE OF WATER irrigation - 3Ac. Temp. \_\_\_\_\_ °F., 19.

SOURCE OF INFORMATION GR-600

DRILLER or DIGGER Barton & Strayer, Beaverton, Ore.

ADDITIONAL DATA:

Log \_\_\_\_\_ Water Level Measurements \_\_\_\_\_ Chemical Analysis \_\_\_\_\_ Aquifer Test \_\_\_\_\_

REMARKS: ↓

Soil & clay - - - - 0' to 75'  
Rock - basalt - - - - 75' to 291'  
Honey comb rock - - 291' to ?