

STATE ENGINEER
Salem, Oregon

WASH
008922

Well Record

STATE WELL NO. 1/1W-19R
COUNTY Washington
APPLICATION NO. GR-3364

OWNER: J. S. Higgins


MAILING ADDRESS: 7900 SW 170th

LOCATION OF WELL: Owner's No.

CITY AND STATE: Beaverton, Oregon

SE 1/4 SE 1/4 Sec. 19 T. 1 S., R. 1 W., W.M.

Bearing and distance from section or subdivision corner property line on West is 170th Ave. on South, County Road 223

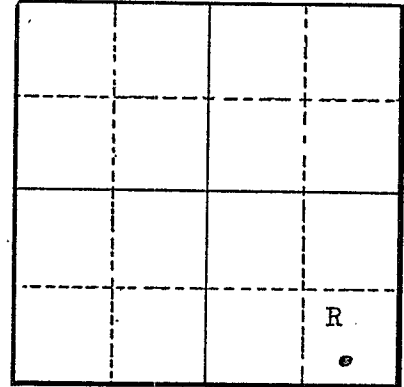

Section 19

Altitude at well 305 feet

TYPE OF WELL: Drilled Date Constructed 5-20-47

Depth drilled 242 feet Depth cased 224 feet

CASING RECORD:

6-inch I. D. casing set from 0 to 224 - 8/12

FINISH:

AQUIFERS:

rock and clay

WATER LEVEL:

21 feet

PUMPING EQUIPMENT: Type Goulds double action, 1-1/2 inch H.P.

Capacity 10 G.P.M.

WELL TESTS:

Drawdown 0 at 212 ft. after 10 hours G.P.M.

Drawdown ft. after hours G.P.M.

USE OF WATER Irrigation Temp. °F., 19

SOURCE OF INFORMATION GR-4062

DRILLER or DIGGER Art. Gaunt Aloha, Oregon

ADDITIONAL DATA:

Log Water Level Measurements Chemical Analysis Aquifer Test

REMARKS:

Clay from	0	175 feet
Sand rock from	175	200 feet
Rock from	200	242 feet
Soft water bearing rock	230	242 feet