

STATE ENGINEER
Salem, Oregon

WASH
008923

Well Record

STATE WELL NO. 1/1W-19R
COUNTY Washington
APPLICATION NO. GR-4050

OWNER: Sch. Dist. No. 94 of Washington
County


MAILING ADDRESS: 7675 SW 170th Ave.

LOCATION OF WELL: Owner's No.

CITY AND STATE: Beaverton, Oregon

SE 1/4 SE 1/4 Sec. 19 T. 1 S., R. 1 W., W.M.

Bearing and distance from section or subdivision
corner 1500' NW of SE Cor. Sec. 19

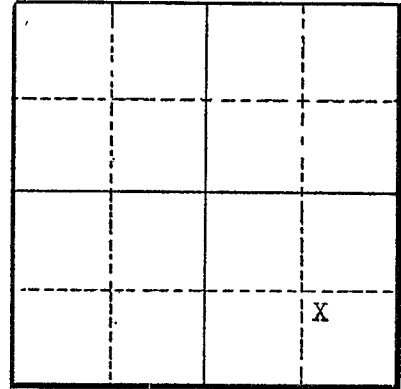

Section 19

Altitude at well

TYPE OF WELL: Drilled Date Constructed 8/2/54

Depth drilled 459 ft. Depth cased 293 ft.

CASING RECORD:

6 inch standard steel casing set to 293 feet

FINISH:

AQUIFERS:

WATER LEVEL:

130 feet below surface

PUMPING EQUIPMENT: Type Peerless H.P. 10
Capacity 50 G.P.M.

WELL TESTS:
Drawdown 119 ft. after 55 hours 53.6 G.P.M.
Drawdown 30 ft. after 15 hours 15 G.P.M.

USE OF WATER Irrigation & School supply Temp. °F. 19

SOURCE OF INFORMATION Well Registration Statement Cert. # GR-3651

DRILLER or DIGGER

ADDITIONAL DATA:

Log X Water Level Measurements Chemical Analysis Aquifer Test

REMARKS: Log Thickness Depth to Bottom
Clay 290 290
Hard rock (basalt) 158 448
(some water, about 3 gpm, at depth of 300')
Lava rock & water bearing 11 459