

STATE ENGINEER  
Salem, Oregon

WASH

Well-Record

STATE WELL NO. 1/1W-19R  
COUNTY Washington  
APPLICATION NO. GR-3005

008925

OWNER: G. Palmer Byrkit

MAILING ADDRESS: 16710 SW Hart Road


LOCATION OF WELL: Owner's No.

CITY AND STATE: Beaverton, Oregon

SE 1/4 SE 1/4 Sec. 19 T. 1 N. S. R. 1 W., W.M.

Bearing and distance from section or subdivision

corner E. 660' of the S. 1320' in the SE 1/4 SE 1/4

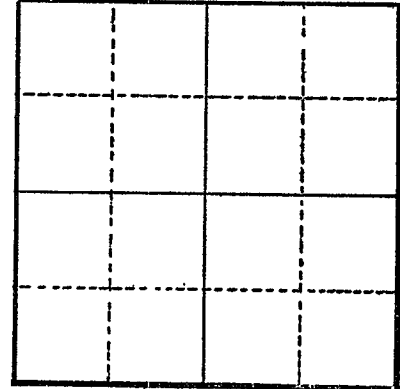

Section

Altitude at well

TYPE OF WELL: drilled Date Constructed 1953

Depth drilled 380' Depth cased

CASING RECORD:

6 inch

FINISH:

AQUIFERS:

clay and rock

WATER LEVEL:

120'

PUMPING EQUIPMENT: Type Pacific Beresford Submers

H.P. 2

Capacity 11 G.P.M.

WELL TESTS:

Drawdown 40 ft. after hours pumping 12 G.P.M.

Drawdown ft. after hours G.P.M.

USE OF WATER Irrigation

Temp. °F. 19

SOURCE OF INFORMATION GR-2814

DRILLER or DIGGER

ADDITIONAL DATA:

Log X Water Level Measurements Chemical Analysis Aquifer Test

REMARKS:

Red & Yellow Clay

180

Rock

180

195

Red & Yellow Clay

195

295

Rock

295

380

Acid water was entering the well between 296' and 340'. The water was shut off by cementing off under pressure and redrilling.