

STATE ENGINEER  
Salem, Oregon

WASH  
008961

# Well Record

STATE WELL NO. 1/w-2051  
COUNTY WASH  
APPLICATION NO. \_\_\_\_\_

OWNER: C. J. Dernbach


MAILING ADDRESS: 15820 S.W. Davis

LOCATION OF WELL: Owner's No. \_\_\_\_\_

CITY AND STATE: Beaverton Oregon

SW  $\frac{1}{4}$  NW  $\frac{1}{4}$  Sec. 20 T. 1 N. S., R. 1 E. W., W.M.

Bearing and distance from section or subdivision corner \_\_\_\_\_

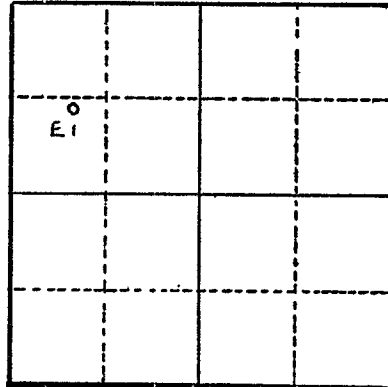

Section 20

Altitude at well \_\_\_\_\_

TYPE OF WELL: Drilled Date Constructed \_\_\_\_\_

Depth drilled 279 Depth cased \_\_\_\_\_

### CASING RECORD:

### FINISH:

### AQUIFERS:

Basalt

### WATER LEVEL:

268 feet in 1953

PUMPING EQUIPMENT: Type Deep well piston H.P. \_\_\_\_\_  
Capacity \_\_\_\_\_ G.P.M.

### WELL TESTS:

Drawdown \_\_\_\_\_ ft. after \_\_\_\_\_ hours \_\_\_\_\_ G.P.M.  
Drawdown \_\_\_\_\_ ft. after \_\_\_\_\_ hours \_\_\_\_\_ G.P.M.

USE OF WATER Domestic Temp. \_\_\_\_\_ °F. \_\_\_\_\_, 19\_\_\_\_

SOURCE OF INFORMATION obs. of owner

DRILLER or DIGGER A.M. Jannsen

### ADDITIONAL DATA:

Log \_\_\_\_\_ Water Level Measurements \_\_\_\_\_ Chemical Analysis \_\_\_\_\_ Aquifer Test \_\_\_\_\_

### REMARKS: