

STATE ENGINEER
Salem, Oregon

WASH

Well Record

STATE WELL NO. 1/1W-20M
COUNTY WASHINGTON
APPLICATION NO. GR-2465

008966

OWNER: Jack L. Barron

MAILING ADDRESS: 16425 S.W. Hart Rd.


LOCATION OF WELL: Owner's No. _____

CITY AND STATE: Beaverton, Oregon

NW 1/4 SW 1/4 Sec. 20 T. 1 S., R. 1 W., W.M.

Bearing and distance from section or subdivision

corner 1,580' N. 8° 31' E.

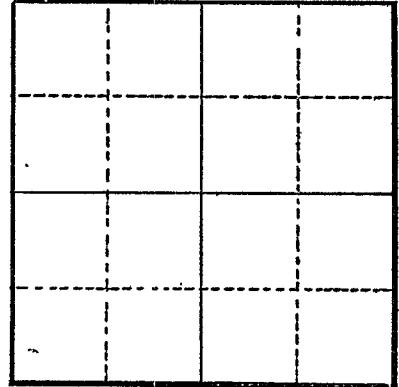

Section _____

Altitude at well _____

TYPE OF WELL: Drilled Date Constructed 1949

Depth drilled 276 Depth cased 233

CASING RECORD:

6-inch

FINISH:

AQUIFERS:

Clay, rock and basalt

WATER LEVEL:

78-feet

PUMPING EQUIPMENT: Type Pacific Jet H.P. 2
Capacity 14 G.P.M.

WELL TESTS:

Drawdown 0 ft. after _____ hours Pumping 14 G.P.M.

Drawdown _____ ft. after _____ hours _____ G.P.M.

USE OF WATER Irrigation Temp. _____ °F. _____, 19____

SOURCE OF INFORMATION GR-2335

DRILLER or DIGGER Lance Strayer, Beaverton, Oregon

ADDITIONAL DATA:

Log X Water Level Measurements _____ Chemical Analysis _____ Aquifer Test _____

REMARKS:

Clay 202 202
Decomposed Rock 31 233
Basalt 43 276